


1 LOCATION OF WATER WELL: Fraction NW 1/4 SW 1/4 SW 1/4 Section Number 7 Township Number T 32 S Range Number R 18 EW

Distance and direction from nearest town or city street address of well if located within city?  
 343 Feet East of Central Street and 30 Feet South of Second Street, Coldwater, KS 01928025 MW-7

2 WATER WELL OWNER: Mr. Vic Kropf  
 RR#, St. Address, Box # : 1215 East 27th Street Board of Agriculture, Division of Water Resources  
 City, State, ZIP Code : Hutchinson, KS 67501 Application Number:

3 LOCATE WELL'S LOCATION WITH AN "X" IN SECTION BOX: 4 DEPTH OF COMPLETED WELL: 57.5 ft. ELEVATION: Approximate Surface Elevation: 2099

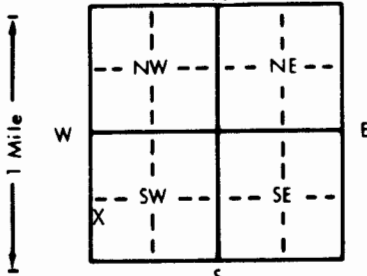

Depth(s) Groundwater Encountered 1. 47.5 ft. 2. ft. 3. ft.  
 WELL'S STATIC WATER LEVEL 47.5 ft. below land surface measured on mo/day/yr 08/13/92  
 Pump test data: Well water was ft. after hours pumping gpm  
 Est. Yield N/A gpm: Well water was ft. after hours pumping gpm  
 Bore Hole Diameter 8.25 in. to 57.5 ft., and in. to ft.  
 WELL WATER TO BE USED AS: 5 Public water supply 8 Air conditioning 11 Injection well  
 1 Domestic 3 Feedlot 6 Oil field water supply 9 Dewatering 12 Other (Specify below)  
 2 Irrigation 4 Industrial 7 Lawn and garden only 10 Monitoring well  
 Was a chemical/bacteriological sample submitted to Department? Yes No X; If yes, mo/day/yr sample was submitted  
 Water Well Disinfected? Yes No X

5 TYPE OF BLANK CASING USED: 5 Wrought iron 8 Concrete tile CASING JOINTS: Glued Clamped  
 1 Steel 3 RMP (SR) 6 Asbestos-Cement 9 Other (specify below) Welded  
 2 PVC 4 ABS 7 Fiberglass Threaded X

Blank casing diameter 2 in. to 37.5 ft., Dia in. to ft., Dia in. to ft.  
 Casing height above land surface -3 in., weight lbs./ft. Wall thickness or gauge No. Schedule 40

TYPE OF SCREEN OR PERFORATION MATERIAL: 7 PVC 10 Asbestos-cement  
 1 Steel 3 Stainless steel 5 Fiberglass 8 RMP (SR) 11 Other (specify)  
 2 Brass 4 Galvanized steel 6 Concrete tile 9 ABS 12 None used (open hole)

SCREEN OR PERFORATION OPENINGS ARE: 5 Gauzed wrapped 8 Saw cut 11 None (open hole)  
 1 Continuous slot 3 Mill slot 6 Wire wrapped 9 Drilled holes  
 2 Louvered shutter 4 Key punched 7 Torch cut 10 Other (specify)

SCREEN-PERFORATED INTERVALS: From 37.5 ft. to 57.5 ft. From ft. to ft.  
 From ft. to ft. From ft. to ft.  
 GRAVEL PACK INTERVALS: From 35.5 ft. to 57.5 ft. From ft. to ft.  
 From ft. to ft. From ft. to ft.

6 GROUT MATERIAL: 1 Neat cement 2 Cement grout 3 Bentonite 4 Other  
 Grout Intervals: From 0 ft. to 33.5 ft., From 33.5 ft. to 35.5 ft., From ft. to ft.

What is the nearest source of possible contamination:  
 1 Septic tank 4 Lateral lines 7 Pit privy 10 Livestock pens 14 Abandoned water well  
 2 Sewer lines 5 Cess pool 8 Sewage lagoon 11 Fuel storage 15 Oil well/Gas well  
 3 Watertight sewer lines 6 Seepage pit 9 Feedyard 12 Fertilizer storage 16 Other (specify below)  
 13 Insecticide storage

Direction from well? How many feet?

FROM	TO	LITHOLOGIC LOG	FROM	TO	PLUGGING INTERVALS
0.0	7.5	Sandy Fat Clay, Tan			
7.5	16.5	Medium Sand With Fat Clay, Tan			
16.5	21.0	Medium Sand, Tan			
21.0	26.0	Medium to Coarse Sand, Tan			
26.0	39.5	Sandy Fat Clay, Tan			
39.5	45.0	Medium Sand, Tan			
45.0	57.5	Medium to Coarse Sand, Tan			

7 CONTRACTOR'S OR LANDOWNER'S CERTIFICATION: This water well was (1) constructed, (2) reconstructed, or (3) plugged under my jurisdiction and was completed on (mo/day/year) 08/13/92 and this record is true to the best of my knowledge and belief. Kansas Water Well Contractor's License No. 416 This Water Well Record was completed on (mo/day/yr) 08-13-92 under the business name of Terracon Consultants, Inc. by (signature) Steve Fischer