


1 LOCATION OF WATER WELL: Fraction SW 1/4 NE 1/4 SE 1/4 Section Number 12 Township Number T 32 S Range Number R 19 E/W

Distance and direction from nearest town or city street address of well if located within city? Convenience Plus #8, 122 S Central - Coldwater, KS

2 WATER WELL OWNER: Wes-Kan Oil Co., Inc. RR#, St. Address, Box #: 130 W. Pancake Board of Agriculture, Division of Water Resources City, State, ZIP Code: Liberal, Kansas 67901 Application Number:

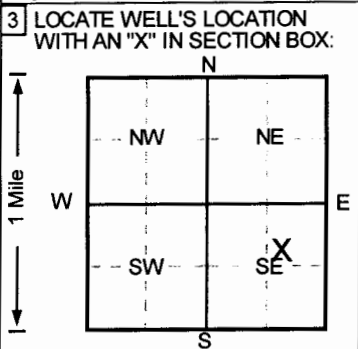

4 DEPTH OF COMPLETED WELL: 75 ft. ELEVATION: 2106.8. WELL'S STATIC WATER LEVEL: 57.83 ft. below land surface measured on mo/day/yr 10/23/96. Pump test data: Well water was NA ft. after NA hours pumping. Est. Yield NA gpm; Well water was NA ft. after NA hours pumping. Bore Hole Diameter 8 in. to 75 ft. and in. to ft. WELL WATER TO BE USED AS: 5 Public water supply, 8 Air conditioning, 11 Injection well, 10 Monitoring well.

5 TYPE OF BLANK CASING USED: 2 PVC, 3 RMP (SR), 4 ABS, 5 Wrought iron, 6 Asbestos-Cement, 7 Fiberglass, 8 Concrete tile, 9 Other (specify below), 10 Asbestos-cement, 11 Other (specify), 12 None used (open hole). Blank casing diameter 2 in. to 45 ft., Dia. in. to ft., Dia. in. to ft. Casing height above land surface 3 in., weight lbs./ft. Wall thickness or gauge No. Sch. 40. TYPE OF SCREEN OR PERFORATION MATERIAL: 7 PVC, 10 Asbestos-cement. SCREEN OR PERFORATION OPENINGS ARE: 3 Mill slot. SCREEN-PERFORATED INTERVALS: From 45 ft. to 75 ft. GRAVEL PACK INTERVALS: From 43 ft. to 75 ft.

6 GROUT MATERIAL: 2 Cement grout, 3 Bentonite, 4 Other. Grout Intervals: From 0 ft. to 41 ft., From 41 ft. to 43 ft., From ft. to ft. What is the nearest source of possible contamination: 16 Other (specify below) UST Basin. Direction from well? SE. How many feet? 1200.

Table with columns: FROM, TO, LITHOLOGIC LOG, FROM, TO, PLUGGING INTERVALS. Rows include lithologic logs: 0-1 Clay, Dark Brown; 1-8 Sand, Brown; 8-23 Sand, Brown; 23-63 Sand, Brown; 63-75 Sand, Brown.

7 CONTRACTOR'S OR LANDOWNER'S CERTIFICATION: This water well was (1) constructed, (2) reconstructed, or (3) plugged under my jurisdiction and was completed on (mo/day/year) 10/18/96 and this record is true to the best of my knowledge and belief. Kansas Water Well Contractor's License No. 527. This Water Well Record was completed on (mo/day/yr) 11/18/96 under the business name of GeoCore Services, Inc. by (signature) Dale Robl.

INSTRUCTIONS: Use typewriter or ball point pen. PLEASE PRESS FIRMLY and PRINT clearly. Please fill in blanks, underline or circle the correct answers. Send top three copies to Kansas Department of Health and Environment, Bureau of Water, Topeka, Kansas 66620-0001. Telephone: 913-296-5545. Send one to WATER WELL OWNER and retain one for your records.

OFFICE USE ONLY

T

R

EW

SEC.

1/4

1/4

1/4