


1 LOCATION OF WATER WELL: County: COMANCHE Fraction: SE 1/4 NW 1/4 SW 1/4 Section Number: 2 Township Number: T 32 S Range Number: R 19 E 19

Distance and direction from nearest town or city street address of well if located within city? From Coldwater 2 W 1/2 N 1/4 E

2 WATER WELL OWNER: GILBERT PARK RR#, St. Address, Box #: Protection, KS 67127 City, State, ZIP Code: Protection, KS Board of Agriculture, Division of Water Resources Application Number:

3 LOCATE WELL'S LOCATION WITH AN "X" IN SECTION BOX:

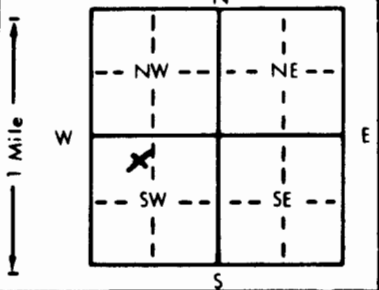

4 DEPTH OF COMPLETED WELL: 85 ft. ELEVATION: 60 ft. Depth(s) Groundwater Encountered 1. 60 ft. 2. 60 ft. 3. 60 ft. WELL'S STATIC WATER LEVEL 60 ft. below land surface measured on mo/day/yr Pump test data: Well water was 5 gpm: Well water was 85 ft. after 5 hours pumping 5 gpm Est. Yield 5 gpm: Well water was 85 ft. after 5 hours pumping 5 gpm Bore Hole Diameter 10 in. to 85 ft., and 85 in. to 85 ft. WELL WATER TO BE USED AS: 5 Public water supply 8 Air conditioning 11 Injection well 1 Domestic 3 Feedlot 6 Oil field water supply 9 Dewatering 12 Other (Specify below) 2 Irrigation 4 Industrial 7 Lawn and garden only 10 Monitoring well

5 TYPE OF BLANK CASING USED: 1 Steel 3 RMP (SR) 5 Wrought iron 8 Concrete tile CASING JOINTS: Glued Clamped 2 PVC 4 ABS 6 Asbestos-Cement 9 Other (specify below) Welded Threaded 7 Fiberglass


TYPE OF SCREEN OR PERFORATION MATERIAL: 1 Steel 3 Stainless steel 5 Fiberglass 8 RMP (SR) 10 Asbestos-cement 2 Brass 4 Galvanized steel 6 Concrete tile 9 ABS 11 Other (specify) 12 None used (open hole) 7 PVC

SCREEN OR PERFORATION OPENINGS ARE: 1 Continuous slot 3 Mill slot 5 Gauzed wrapped 8 Saw cut 11 None (open hole) 2 Louvered shutter 4 Key punched 6 Wire wrapped 9 Drilled holes 10 Other (specify)



What is the nearest source of possible contamination: 1 Septic tank 4 Lateral lines 7 Pit privy 10 Livestock pens 14 Abandoned water well 2 Sewer lines 5 Cess pool 8 Sewage lagoon 11 Fuel storage 15 Oil well/Gas well 3 Watertight sewer lines 6 Seepage pit 9 Feedyard 12 Fertilizer storage 16 Other (specify below) NONE 13 Insecticide storage

Direction from well? How many feet?

FROM	TO	LITHOLOGIC LOG	FROM	TO	PLUGGING INTERVALS
<u>0</u>	<u>60</u>	<u>SAND CLAY</u>			
<u>60</u>	<u>80</u>	<u>SAND GRAVEL</u>			
<u>81</u>	<u>85</u>	<u>WHITE CLAY</u>			

7 CONTRACTOR'S OR LANDOWNER'S CERTIFICATION: This water well was (1) constructed, (2) reconstructed, or (3) plugged under my jurisdiction and was completed on (mo/day/year) 11-15-90 and this record is true to the best of my knowledge and belief. Kansas Water Well Contractor's License No. 411 This Water Well Record was completed on (mo/day/yr) 12-15-90 under the business name of LEHIS WATER WELL by (signature) Ron Luhl

OFFICE USE ONLY
T
R
EW
SEC.