


1 LOCATION OF WATER WELL: County: Comanche Fraction: NW 1/4 NW 1/4 SE 1/4 Section Number: 34 Township Number: T 32 S Range Number: R 20 E 10

Distance and direction from nearest town or city street address of well if located within city?

2 WATER WELL OWNER: Charles Peterson RR#, St. Address, Box #: Protection, Ks 67127 City, State, ZIP Code: Protection, Ks 67127 Board of Agriculture, Division of Water Resources Application Number: MW 6

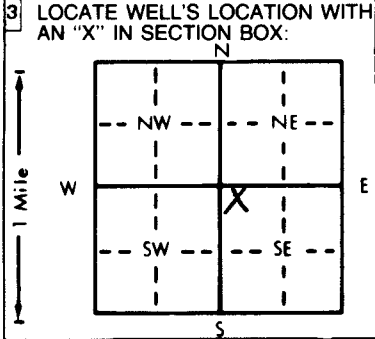

4 DEPTH OF COMPLETED WELL: 15 ft. ELEVATION: \_\_\_\_\_ ft.

Depth(s) Groundwater Encountered: 1 ft. 2. \_\_\_\_\_ ft. 3. \_\_\_\_\_ ft.

WELL'S STATIC WATER LEVEL: 5.14 ft. below land surface measured on mo/day/yr \_\_\_\_\_

Pump test data: Well water was \_\_\_\_\_ ft. after \_\_\_\_\_ hours pumping \_\_\_\_\_ gpm

Est. Yield \_\_\_\_\_ gpm: Well water was \_\_\_\_\_ ft. after \_\_\_\_\_ hours pumping \_\_\_\_\_ gpm

Bore Hole Diameter: 8 in. to 15 ft., and \_\_\_\_\_ in. to \_\_\_\_\_ ft.

WELL WATER TO BE USED AS:

5 Public water supply	8 Air conditioning	11 Injection well
1 Domestic	3 Feedlot	6 Oil field water supply
2 Irrigation	4 Industrial	7 Lawn and garden only
		10 <u>Monitoring well</u>

12 Other (Specify below) \_\_\_\_\_

Was a chemical/bacteriological sample submitted to Department? Yes \_\_\_\_\_ No X; If yes, mo/day/yr sample was submitted \_\_\_\_\_

Water Well Disinfected? Yes \_\_\_\_\_ No X

5 TYPE OF BLANK CASING USED:

1 Steel	3 RMP (SR)	5 Wrought iron	8 Concrete tile	CASING JOINTS: Glued _____ Clamped _____
<u>2 PVC</u>	4 ABS	6 Asbestos-Cement	9 Other (specify below)	Welded _____
		7 Fiberglass		Threaded <u>X</u>

Blank casing diameter: 2 in. to 5 ft., Dia \_\_\_\_\_ in. to \_\_\_\_\_ ft., Dia \_\_\_\_\_ in. to \_\_\_\_\_ ft.

Casing height above land surface: 38 in., weight 716 lbs./ft. Wall thickness or gauge No. 154

TYPE OF SCREEN OR PERFORATION MATERIAL:

1 Steel	3 Stainless steel	5 Fiberglass	8 RMP (SR)	10 Asbestos-cement
2 Brass	4 Galvanized steel	6 Concrete tile	9 ABS	11 Other (specify) _____
				12 None used (open hole)

SCREEN OR PERFORATION OPENINGS ARE:

1 Continuous slot	3 Mill slot	5 Gauzed wrapped	<u>8 Saw cut</u>	11 None (open hole)
2 Louvered shutter	4 Key punched	6 Wire wrapped	9 Drilled holes	
		7 Torch cut	10 Other (specify) _____	

SCREEN-PERFORATED INTERVALS: From \_\_\_\_\_ ft. to 15 ft., From \_\_\_\_\_ ft. to \_\_\_\_\_ ft.

GRAVEL PACK INTERVALS: From \_\_\_\_\_ ft. to 15 ft., From \_\_\_\_\_ ft. to \_\_\_\_\_ ft.

6 GROUT MATERIAL: 1 Neat cement 2 Cement grout 3 Bentonite 4 Other \_\_\_\_\_

Grout Intervals: From 0 ft. to \_\_\_\_\_ ft., From 3 ft. to \_\_\_\_\_ ft., From 4 ft. to \_\_\_\_\_ ft.

What is the nearest source of possible contamination:

1 Septic tank	4 Lateral lines	7 Pit privy	10 Livestock pens	14 Abandoned water well
2 Sewer lines	5 Cess pool	8 Sewage lagoon	11 Fuel storage	15 Oil well/Gas well
3 Watertight sewer lines	6 Seepage pit	9 Feedyard	12 Fertilizer storage	16 Other (specify below)
			13 Insecticide storage	<u>contaminated site</u>

Direction from well? \_\_\_\_\_ How many feet? \_\_\_\_\_

FROM	TO	LITHOLOGIC LOG	FROM	TO	PLUGGING INTERVALS
<u>0</u>	<u>5</u>	<u>Sandy clay, fine to med sand</u>			
<u>5</u>	<u>15</u>	<u>fine to med sand</u>			

7 CONTRACTOR'S OR LANDOWNER'S CERTIFICATION: This water well was (1) ~~constructed~~ (2) reconstructed, or (3) plugged under my jurisdiction and was completed on (mo/day/year) 10-15-97 and this record is true to the best of my knowledge and belief. Kansas Water Well Contractor's License No. 554 This Water Well Record was completed on (mo/day/yr) 1-29-98 under the business name of Woolter Pump Well, Inc by (signature) [Signature]

OFFICE USE ONLY

T

R

EM

SEC.

1/4

1/4

1/4