

1	LOCATION OF WATER WELL: County: <u>Comanche</u>	Fraction <u>NE</u> $\frac{1}{4}$ <u>NW</u> $\frac{1}{4}$ <u>SW</u> $\frac{1}{4}$	Section Number <u>4</u>	Township Number T <u>32</u> S	Range Number R <u>20</u> E
---	--	---	----------------------------	----------------------------------	-------------------------------

Distance and direction from nearest town or city street address of well if located within city?

From Protection Ks 1 West 12 N 6th


2 WATER WELL OWNER: John NERD

RR#, St. Address, Box # :
City, State, ZIP Code : Protection Ks

Board of Agriculture, Division of Water Resources
Application Number:

3 LOCATE WELL'S LOCATION WITH 4 DEPTH OF COMPLETED WELL 30 ft. ELEVATION:

AN "X" IN SECTION BOX:

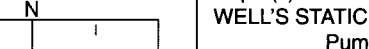

Depth(s) Groundwater Encountered 1 2 ft. 3 ft.

WELL'S STATIC WATER LEVEL 8 ft. below land surface measured on mo/day/yr

Pump test data: Well water was ft. after hours pumping gpm

Est. Yield 50 gpm: Well water was ft. after hours pumping gpm

WELL WATER TO BE USED AS:

1 Domestic	3 Feedlot	5 Public water supply	8 Air conditioning	11 Injection well
2 Irrigation	4 Industrial	6 Oil field water supply	9 Dewatering	12 Other (Specify below)
		7 Domestic (lawn & garden)	10 Monitoring well	

Was a chemical/bacteriological sample submitted to Department? Yes No If yes, mo/day/yr sample was submitted

Water Well Disinfected? Yes No

5 TYPE OF BLANK CASING USED:		5 Wrought iron		8 Concrete tile		CASING JOINTS: Glued ☒ Clamped ☐	
1 Steel		6 Asbestos-Cement		9 Other (specify below)		Welded ☐	
<u>2 PVC</u>		7 Fiberglass				Threaded ☐	
17 Blank casing diameter <u>5</u> in. to <u>20</u> ft., Dia							
Casing height above land surface <u>24</u> in., weight <u>2.37</u> lbs./ft.						Wall thickness or guage No. <u>214</u>	
TYPE OF SCREEN OR PERFORATION MATERIAL:				<u>7 PVC</u>			
1 Steel		3 Stainless Steel		8 RMP (SR)		10 Asbestos-Cement	
2 Brass		4 Galvanized Steel		9 ABS		11 Other (Specify) ☐	
		5 Fiberglass				12 None used (open hole)	
		6 Concrete tile					
SCREEN OR PERFORATION OPENINGS ARE:				5 Guazed wrapped		8 Saw cut	
1 Continuous slot		<u>3 Mill slot</u>		6 Wire wrapped		11 None (open hole)	
2 Louvered shutter		4 Key punched		7 Torch cut		9 Drilled holes	
						10 Other (specify) ☐	
SCREEN-PERFORATED INTERVALS:		From <u>20</u> ft. to <u>30</u> ft.,		From ☐ ft. to ☐ ft.,			
		From ☐ ft. to ☐ ft.,		From ☐ ft. to ☐ ft.,			
GRAVEL PACK INTERVALS:		From <u>20</u> ft. to <u>30</u> ft.,		From ☐ ft. to ☐ ft.,			
		From ☐ ft. to ☐ ft.,		From ☐ ft. to ☐ ft.,			

6] GROUT MATERIAL:		1 Neat cement	2 <u>Cement grout</u>	3 Bentonite	4 Other.....
Grout Intervals:		From <u>0</u> ft. to <u>20</u> ft.	From	ft. to	ft. From ft. to ft.
What is the nearest source of possible contamination:				10 Livestock pens	14 Abandoned water well
1 Septic tank	4 Lateral lines	7 Pit privy	11 Fuel storage	15 Oil well/Gas well	
2 Sewer lines	5 Cess pool	8 Sewage lagoon	12 Fertilizer storage	16 Other (specify below)	
3 Watertight sewer lines	6 Seepage pit	9 Feedyard	13 Insecticide storage	<u>NONE</u>	
Direction from well?			How many feet?		

[illegible]

7. CONTRACTOR'S OR LANDOWNER'S CERTIFICATION: This water well was (1) constructed, (2) reconstructed, or (3) plugged under my jurisdiction and was completed on (mo/day/year) 6-17-06 and this record is true to the best of my knowledge and belief. Kansas Water Well Contractor's Licence No. 411. This Water Well Record was completed on (mo/day/yr) 6-23-06 under the business name of LEHIS WATER WELL by (signature) Ronald C Lehl