USE TYPEWRITER OR BALL POINT PEN-PRESS FIRMLY, PRINT CLEARLY.

T R EW sec 1/4 1/4 1/4 No.

WATER WELL RECORD
KSA 82a-1201-1215

Kansas State Dept. Of Health
(Water Well Contractors)
Forbes-Bldg. 740
Topeka, Kansas 66620

1 Location of well:	County	Township name	Fraction	Section number	Town number	Range number
	COMANCHE	PROTECTION	NE¼ SW¼ NW¼	7	32	20

Distance and direction from nearest town or city: 4 - N., 3 W, ¾ N

Street address of well location if in city:

3 Owner of well: JOY HENDRIX

Address: PROTECTION, KANS. 67127

Locate with "X" in section below:

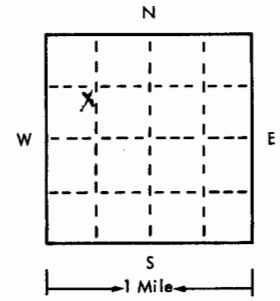

Sketch map:

4 Well depth: 42 ft. Date of completion 4-18-75
Well diameter 8 in.

5 ☒ Cable tool ☐ Rotary ☐ Driven ☐ Dug
☐ Hollow rod ☐ Jetted ☐ Bored ☐ Reverse rotary

6 Use: ☐ Domestic ☐ Public supply ☐ Industry
☐ Irrigation ☐ Air conditioning ☐ Commercial
☐ Test well ☒ PASTURE

7 Casing: Material RMP Height: (above)/below
Threaded ☐ Welded ☐ Surface 20 in.
Diam. Weight ____ lbs./ft.
5 in. to 42 ft. depth Drive shoe? ☐ Yes ☒ No
____ in. to ____ ft. depth

2 Type and color of material	From	To
DUNE SAND	0	12
SANDY CLAY	12	32
SAND - GRAVEL	32	42
STOPPED IN GRAVEL		

(use a second sheet if needed)

8 Screen:
Manufacturer JESS + LOWELL
Type RMP Dia. 5
Slot/gauze SAW CUT Length 10'
Set between 32 ft. and 42 ft.
Fittings:
Gravel pack ☒ Yes ☐ No Size range of material ⅛ - ¾

9 Static water level:
23 ft. below land surface Date 4-18-75

10 Pumping level below land surfaces:
____ ft. after ____ hrs. pumping ____ g.p.m.
____ ft. after ____ hrs. pumping ____ g.p.m.
Estimated maximum yield ____ g.p.m.

11 Water sample submitted:
☐ Yes ☐ No Date ____

12 Well head completion:
☐ Pitless adapter 26 Inches above grade

13 Well grouted? ☒ Yes ☐ No
☐ Neat cement ☐ Bentonite ☒ CONCRETE
Depth: From 10 ft. to 20 ft.

14 Nearest source of possible contamination: IN Pasture
ft. ____ Direction ____ Type ____
Well disinfected upon completion? ☒ Yes ☐ No

15 Pump: ☐ Not installed
Manufacturer's name AERMOTER
Model number ____ HP WIND Volts ____
Length of drop pipe 40 ft. capacity ____ g.m.p.
Type:
☐ Submersible ☐ Turbine
☐ Jet ☒ Reciprocating
☐ Certrifugal ☐ Other

16 Remarks: elevation

6⅝ iron pipe set in concrete to 26" above grade - protected the RMP and hold the pump. Hole is in 18" of concrete

Topography:
☒ Hill
☐ Slope
☐ Upland
☐ Valley

17 Water well contractor's certification:
This well was drilled under my jurisdiction and this report is true to the best of my knowledge and belief.
WIMER BLACKSMITH SHOP 228
Business name License No.
Address: PROTECTION, KS. 67127
Signed Kenneth X Wimer Date 4-23-75
Authorized representative

Forward the white, blue and pink copies to the Kansas State Dept. Of Health.

Form WWC-5

677-H