USE TYPEWRITER OR BALL POINT PEN-PRESS FIRMLY, PRINT CLEARLY.

T R EW sec 1/4 1/4 1/4 No.

WATER WELL RECORD
KSA 82a-1201-1215

Kansas State Dept. Of Health
(Water Well Contractors)
Forbes-Bldg. 740
Topeka, Kansas 66620

1 Location of well:	County	Township name	Fraction	Section number	Town number	Range number
	COMANCHE	PROTECTION	CW 1/2 SE 1/4	15	32	20W

Distance and direction from nearest town or city: 3½ m. north of
Street address of well location if in city: NE CORNER / PROTECTION

3 Owner of well: WILLIAM L. DALE
Address: PROTECTION, KS. 67127

Locate with "X" in section below:

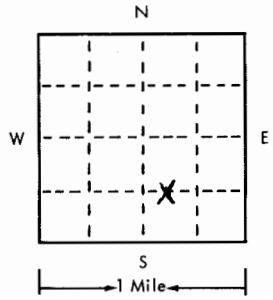

Sketch map:

4 Well depth: 44 ft. Date of completion 4-16-76
Well diameter 9 in.

5 [X] Cable tool [ ] Rotary [ ] Driven [ ] Dug
[ ] Hollow rod [ ] Jetted [ ] Bored [ ] Reverse rotary

6 Use: [ ] Domestic [ ] Public supply [ ] Industry
[ ] Irrigation [ ] Air conditioning [ ] Commercial
[ ] Test well [X] PASTURE

7 Casing: Material RMP Height: above/below
Threaded [ ] Welded [ ] Surface 16 in.
Diam. 5 in. to 44 ft. depth Weight ____ lbs./ft.
____ in. to ____ ft. depth Drive shoe? [ ] Yes [ ] No

2 Type and color of material	From	To
BLOW SAND	0	4
BLACK CLAY	4	31
SAND	31	33
BLACK CLAY	33	38
WATER SAND	38	44
(use a second sheet if needed)		

8 Screen:
Manufacturer JESS T LOWELL
Type RMP Dia. 5"
Slot/gauze SAW Length 10'
Set between 34 ft. and 44 ft.
Fittings:
Gravel pack [X] Yes [ ] No Size range of material 3/4

9 Static water level:
6 ft. below land surface Date 4-16-76

10 Pumping level below land surfaces:
____ ft. after ____ hrs. pumping ____ g.p.m.
____ ft. after ____ hrs. pumping ____ g.p.m.
Estimated maximum yield 8 g.p.m.

11 Water sample submitted:
[ ] Yes [ ] No Date ____

12 Well head completion:
[ ] Pitless adapter 12 inches above grade

13 Well grouted? [X] Yes [ ] No
[ ] Neat cement [ ] Bentonite [X] Concrete
Depth: From 0 ft. to 6 ft.

14 Nearest source of possible contamination:
ft. ____ Direction ____ Type ____
Well disinfected upon completion? [X] Yes [ ] No

15 Pump: [ ] Not installed
Manufacturer's name NOT KNOWN, pump jack
Model number ____ HP ____ Volts ____
Length of drop pipe 20 ft. capacity ____ g.m.p.
Type:
[ ] Submersible [ ] Turbine
[ ] Jet [X] Reciprocating
[ ] Centrifugal [ ] Other

16 Remarks: elevation

Topography:
[X] Hill
[ ] Slope
[ ] Upland
[ ] Valley

LOW RIDGE BETWEEN SLOUGHS

17 Water well contractor's certification:
This well was drilled under my jurisdiction and this report is true to the best of my knowledge and belief.
Business name WYMER BLACKSMITH SHOP License No. 228
Address PROTECTION, KS. 67127
Signed Kenneth Lurpin Date 4-16-76
Authorized representative

Forward the white, blue and pink copies to the Kansas State Dept. Of Health.

Form WWC-5

677-H

32 20W 15 CW½ SE