USE TYPEWRITER OR BALL POINT PEN-PRESS FIRMLY, PRINT CLEARLY.

WATER WELL RECORD
KSA 82a-1201-1215

Kansas Department of Health and Environment-Division of Environment
(Water well Contractors)
Topeka, Kansas 66620

1. Location of well:	County: Comanche	Fraction: c nl/4 of nw1/4 (1/4 1/4 1/4)	Section number: 26	Township number: T 32s S	Range number: R 20w E/W

2. Distance and direction from nearest town or city: 2 miles north, 1/4 east from Protection, Ks.
Street address of well location if in city:

3. Owner of well: William L. Dale
R.R. or street: Protection, Ks. 67127
City, state, zip code:

4. Locate with "X" in section below:

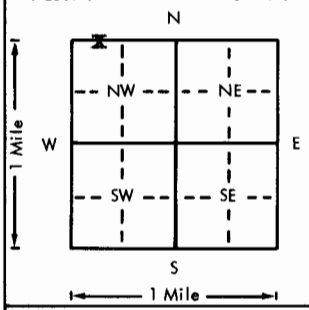

Sketch map:

6. Bore hole dia. 8.75 in. Completion date _____
Well depth 49 ft. 10 - 25 - 79

7. X Cable tool __ Rotary __ Driven __ Dug
__ Hollow rod __ Jetted __ Bored __ Reverse rotary

8. Use: X Domestic __ Public supply __ Industry
__ Irrigation __ Air conditioning __ Stock
__ Lawn __ Oil field water __ Other

9. Casing: Material _____ Height: Above or below
Threaded ____ Welded ____ Surface 14 in.
RMP X PVC ____ Weight _____ lbs./ft.
Dia. 5 in. to 49 ft. depth Wall Thickness: inches or
Dia. ____ in. to ____ ft. depth gage No. .250

5. Type and color of material	From	To
Red clay topsoil	0	4
Black clay	4	10
Gray clay	10	17
~~Tan sandy clay~~	~~17~~	~~39~~
Sand mixed fine to coarse	39	49
(stopped in sand)		
(Use a second sheet if needed)		

10. Screen: Manufacturer's name Jess & Lowell
Type Rmp Dia. 5 in.
Slot/gauze saw Length 10 ft.
Set between 39 ft. and 49 ft.
_____ ft. and _____ ft.
Gravel pack? yes Size range of material 1/16-3/4

11. Static water level: 17 ft. below land surface Date 10-25-79 mo./day/yr.

12. Pumping level below land surfaces:
17.5 ft. after 1 hrs. pumping 4 g.p.m.
____ ft. after ____ hrs. pumping ____ g.p.m.
Estimated maximum yield 10 g.p.m.

13. Water sample submitted: mo./day/yr.
__ Yes X No Date _____

14. Well head completion:
__ Pitless adapter 14 Inches above grade

15. Well grouted? yes
With: __ Neat cement __ Bentonite X Concrete
Depth: From 0 ft. to 10 ft.

16. Nearest source of possible contamination:
ft. 75 Direction se Type poultry
Well disinfected upon completion? yes Yes ____ No

17. Pump: ____ Not installed
Manufacturer's name _____
Model number _____ HP 1/2 Volts 115
Length of drop pipe 30 ft. capacity 4 g.p.m.
Type:
__ Submersible __ Turbine
__ Jet X Reciprocating
__ Centrifugal __ Other

18. Elevation:

Topography:
__ Hill
X Slope
__ Upland
__ Valley

19. Remarks:
owner will install 4 ft. slab and well house
owner is awawe of this requirement

20. Water well contractor's certification:
This well was drilled under my jurisdiction and this report is true to the best of my knowledge and belief.
Wymer Blacksmith Shop 228
Business name Box 172 Protection Ks. 67127 License No.
Address
Signed Kenneth L. Wymer Date 11-4-79
Authorized representative

T 32 R 20 (W) E Sec 26 1/4 1/4 1/4 1/4

Forward the white, blue and pink copies to the Department of Health and Environment

Form WWC-5

MI-1023