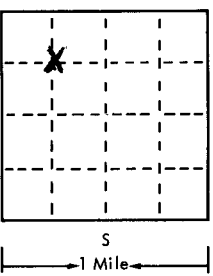
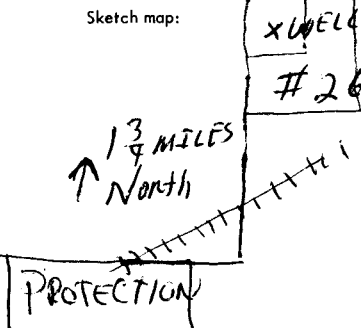


USE TYPEWRITER OR BALL POINT PEN-PRESS FIRMLY, PRINT CLEARLY.

WATER WELL RECORD
KSA 82a-1201-1215

T R EW sec 1/4 1/4 1/4 No.

Kansas State Dept. Of Health
(Water Well Contractors)
Forbes-Bldg. 740
Topeka, Kansas 66620

1 Location of well:	County Commanche	Township name	Fraction NW 1/4 - CENTER	Section number 26	Town number T 32 S	Range number R 20 W
Distance and direction from nearest town or city: 1 E, 3 N of Protection, Kansas Street address of well location if in city:				3 Owner of well: Bill Dale Address: Protection, Kansas		
Locate with "X" in section below: N  W E S 1 Mile		Sketch map: 		4 Well depth: <u>150</u> ft. Date of completion <u>4-76</u> Well diameter <u>28</u> in.		
2 Type and color of material		From		To		5 <input type="checkbox"/> Cable tool <input type="checkbox"/> Rotary <input type="checkbox"/> Driven <input type="checkbox"/> Dug <input type="checkbox"/> Hollow rod <input type="checkbox"/> Jetted <input type="checkbox"/> Bored <input checked="" type="checkbox"/> Reverse rotary
		Top Soil		0 5		6 Use: <input type="checkbox"/> Domestic <input type="checkbox"/> Public supply <input type="checkbox"/> Industry <input checked="" type="checkbox"/> Irrigation <input type="checkbox"/> Air conditioning <input type="checkbox"/> Commercial <input type="checkbox"/> Test well <input type="checkbox"/>
		Sandy Gravel		5 35		7 Casing: Material <u>Iron</u> Height: above/below Threaded <input type="checkbox"/> Welded <input checked="" type="checkbox"/> Surface <u>12</u> in. Diam. <u>16</u> in. to <u>60</u> ft. depth Weight <u>134</u> lbs./ft. Drive shoe? <input type="checkbox"/> Yes <input checked="" type="checkbox"/> No
		Clay		35 50		8 Screen: Manufacturer <u>Doerr</u> Type <u>Iron</u> Dia. <u>16</u> Slot/gauze <u>3/16</u> Length <u>90-150</u> Set between <u>90</u> ft. and <u>150</u> ft. Fittings: Gravel pack <input type="checkbox"/> Yes <input type="checkbox"/> No Size range of material <u>1/4</u> by <u>5/8</u>
		Sand & Gravel		50 120		9 Static water level: <u>35</u> ft. below land surface Date <u>4-76</u>
		Clay		120 140		10 Pumping level below land surfaces: <u>90</u> 85 ft. after <u>2</u> hrs. pumping <u>1150</u> g.p.m. ft. after _____ hrs. pumping _____ g.p.m. Estimated maximum yield <u>1150</u> g.p.m.
		Gravel		140 150		11 Water sample submitted: <input type="checkbox"/> Yes <input checked="" type="checkbox"/> No Date _____
		Sjale		150		12 Well head completion: <u>4-76</u> <input type="checkbox"/> Pitless adapter <input type="checkbox"/> Inches above grade
(use a second sheet if needed)				13 Well grouted? <input checked="" type="checkbox"/> Yes <input type="checkbox"/> No <input type="checkbox"/> Neat cement <input type="checkbox"/> Bentonite <input checked="" type="checkbox"/> <u>Concrete</u> Depth: From <u>0</u> ft. to <u>16</u> ft.		
16 Remarks: elevation <u>FIELD IS FLAT</u> Topography: <input type="checkbox"/> Hill <input type="checkbox"/> Slope <input checked="" type="checkbox"/> Upland <input type="checkbox"/> Valley <u>Pump Completed July 21, 1976</u>				15 Pump <u>Goulds</u> <input type="checkbox"/> Not installed Manufacturer's name <u>Goulds Pumps, Inc</u> Model number _____ HP _____ Volts _____ Length of drop pipe <u>140</u> ft. capacity <u>800</u> g.p.m. Type: <input type="checkbox"/> Submersible <input checked="" type="checkbox"/> Turbine <input type="checkbox"/> Jet <input type="checkbox"/> Reciprocating <input type="checkbox"/> Centrifugal <input type="checkbox"/> Other		
				17 Water well contractor's certification: This well was drilled under my jurisdiction and this report is true to the best of my knowledge and belief. <u>Alfred W. Buser</u> <u>5/25/76</u> Business name <u>Buy 56 Builders</u> License No. _____ Address _____ Signed <u>Alfred W. Buser</u> Date <u>5/24/76</u> Authorized representative		

32 200 26 CWW