


1 LOCATION OF WATER WELL: Fraction Section Number Township Number Range Number  
 COUNTY: 013 CLARK NW 1/4 SW 1/4 NW 1/4 17 T 32 S R 21 W

Distance and direction from nearest town or city street address of well if located within city?  
 FROM SITKA; APPX 5 3/4 MILES NORTH & 1 MILE EAST

2 WATER WELL OWNER: MARMIK OIL  
 RR#, St. Address, Box #: 200 N. JEFFERSON STE 500 Board of Agriculture, Division of Water Resources  
 City, State, ZIP code: EL DORADO, AR 71730-5855 Application Number:

3 LOCATE WELL'S LOCATION WITH AN "X" IN SECTION BOX:

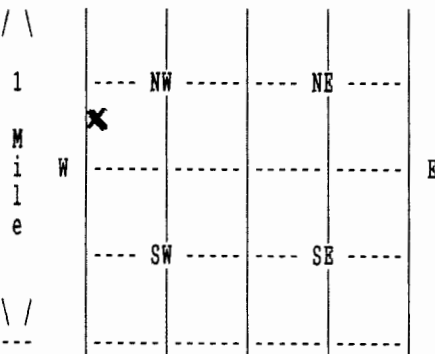

4 DEPTH OF COMPLETED WELL 70 ELEVATION: 0  
 Depth(s) Groundwater Encountered 1. 0 ft. 2. 0 ft. 3. 0 ft.

WELL'S STATIC WATER LEVEL 0 ft. below land surface measured on mo/day/yr  
 Pump test data: Well water was 0 ft. after 0 hours pumping 0 gpm

Estimated Yield 0 gpm: Well water was 0 ft. after 0 hours pumping 0 gpm

Bore Hole Diameter 10 7/8 in. to 70 ft., and in. to 0 ft.

WELL WATER TO BE USED AS: 06 OIL FIELD

Was a chemical/bacteriological sample submitted to department? No ;  
 If yes, mo/day/yr sample was submitted Water well disinfected? Yes

5 TYPE OF BLANK CASING USED: 02 PVC CASING JOINTS: GLUED  
 Blank casing diameter 6 in. to 70 ft., Dia in. to 0 ft., Dia in. to 0 ft.  
 Casing height above land surface 12 in., weight 4 lbs/ft. Wall thickness or gauge No. .316  
 TYPE OF SCREEN OR PERFORATION MATERIAL: 07 PVC  
 SCREEN OR PERFORATION OPENINGS ARE: 01 CONT. SLOT

SCREEN PERFORATED INTERVALS: From 20 ft. to 40 ft., From 0 ft. to 0 ft.  
 From 50 ft. to 70 ft., From 0 ft. to 0 ft.  
 GRAVEL PACK INTERVALS: From 25 ft. to 70 ft., From 0 ft. to 0 ft.  
 From 0 ft. to 0 ft., From 0 ft. to 0 ft.

6 GROUT MATERIAL 03 BENTONITE  
 Grout Intervals: From 0 ft. to 25 ft., From 0 ft. to 0 ft., From 0 ft. to 0 ft.  
 What is the nearest source of possible contamination: NONE OBSERVED  
 Direction from well? How many feet? 0

FROM	TO	LITHOLOGIC LOG	FROM	TO	PLUGGING INTERVALS
0	2	02 SILT			
2	23	05 SAND 11 GRAVEL			
23	31	04 SANDY CLAY			
31	47	05 SAND 13 FINE GRAVEL			
47	56	04 SANDY CLAY			
56	72	05 SAND 13 FINE GRAVEL			
72	74	04 SANDY CLAY			
74	75	19 SHALE			

7 CONTRACTOR'S OR LANDOWNER'S CERTIFICATION: This water well was Constructed under my jurisdiction and was completed on (mo/day/year) 09/13/05 and this record is true to the best of my knowledge and belief. Kansas Water Well Contractor's License No. 145 This Water Well Record was completed on (mo/day/yr) 10/06/05 under the business name of HENKLE DRILLING & SUPPLY by (signature) *Bruce J. Reichert*