


1 LOCATION OF WATER WELL: County: **Clark** Fraction: **SE 1/4 SE 1/4 SE 1/4** Section Number: **34** Township Number: **T 32 S** Range Number: **R 21** **BW**

Distance and direction from nearest town or city street address of well if located within city?
5 mi N of Protection, KS, 1 mi N of US Hwy 160

2 WATER WELL OWNER: **DCP Midstream, LP**
 RR#, St. Address, Box # : **370 17th Street, Ste 2500** Board of Agriculture, Division of Water Resources
 City, State, ZIP Code : **Denver, CO 80202** Application Number:

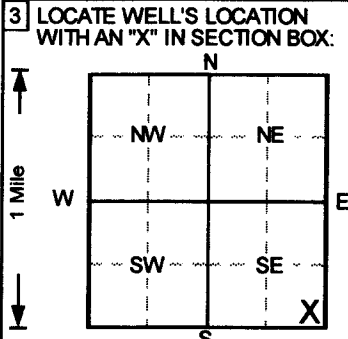

4 DEPTH OF COMPLETED WELL: **37** ft. ELEVATION:
 Depth(s) Groundwater Encountered 1. **25** ft. 2. ft. 3. ft.
 WELL'S STATIC WATER LEVEL ft. below land surface measured on mo/day/yr
 Pump test data: Well water was **NA** ft. after hours pumping gpm
 Est. Yield .. **NA** .. gpm: Well water was ft. after hours pumping gpm
 Bore Hole Diameter **8** in. to **37** ft., and in. to ft.
 WELL WATER TO BE USED AS:
 5 Public water supply 8 Air conditioning 11 Injection well
 1 Domestic 3 Feedlot 6 Oil field water supply 9 Dewatering **(12) Other (Specify below)**
 2 Irrigation 4 Industrial 7 Lawn and garden only 10 Monitoring well Air sparge
 Was a chemical/bacteriological sample submitted to Department? Yes.....No ; If yes, mo/day/yr sample was submitted
 Water Well Disinfected? Yes No

5 TYPE OF BLANK CASING USED:
 1 Steel 3 RMP (SR) 5 Wrought iron 8 Concrete tile CASING JOINTS: Glued .. Clamped ..
(2) PVC 4 ABS 6 Asbestos-Cement 9 Other (specify below) Welded ..
 Blank casing diameter **2** in. to **32** ft. Dia. in. to ft. Dia. in. to ft.
 Casing height above land surface **0** in. weight lbs./ft. Wall thickness or gauge No. **Sch. 40**
 TYPE OF SCREEN OR PERFORATION MATERIAL
 1 Steel 3 Stainless steel 5 Fiberglass **(7) PVC** 10 Asbestos-cement
 2 Brass 4 Galvanized steel 6 Concrete tile 8 RMP (SR) 11 Other (specify)
 SCREEN OR PERFORATION OPENINGS ARE:
 1 Continuous slot **(3) Mill slot** 5 Gauzed wrapped 8 Saw cut 11 None (open hole)
 2 Louvered shutter 4 Key punched 6 Wire wrapped 9 Drilled holes
 7 Torch cut 10 Other (specify)
 SCREEN-PERFORATED INTERVALS: From **32** ft. to **37** ft. From ft. to ft.
 GRAVEL PACK INTERVALS: From **30** ft. to **37** ft. From ft. to ft.

6 GROUT MATERIAL: 1 Neat cement 2 Cement grout **(3) Bentonite** **(4) Other Concrete**
 Grout intervals: From **0** ft. to **1** ft. From **1** ft. to **30** ft. From ft. to ft.
 What is the nearest source of possible contamination:
 1 Septic tank 4 Lateral lines 7 Pit privy 10 Livestock pens 14 Abandoned water well
 2 Sewer lines 5 Cess pool 8 Sewage lagoon 11 Fuel storage 15 Oil well/Gas well
 3 Watertight sewer lines 6 Seepage pit 9 Feedyard 12 Fertilizer storage 16 Other (specify below)
 Direction from well? How many feet?

FROM	TO	LITHOLOGIC LOG	FROM	TO	PLUGGING INTERVALS
0	9	Sand, Red Brown			
9	12	Sand, silty, Red Brown			
12	14.5	Clay, Gray			
14.5	22	Clay, silty, Red Brown			
22	37	Sand, clayey, silty, Red Brown			
					AS-5

7 CONTRACTOR'S OR LANDOWNER'S CERTIFICATION: This water well was **(1)** constructed, (2) reconstructed, or (3) plugged under my jurisdiction and was completed on (mo/day/year) **12/2/2015** and this record is true to the best of my knowledge and belief.
 Kansas Water Well Contractor's License No. **527** This Water Well Record was completed on (mo/day/yr) **12/3/15**
 under the business name of **GeoCore, Inc.** by (signature) *Dale Robinson*

INSTRUCTIONS: Use typewriter or ball point pen. PLEASE PRESS FIRMLY and PRINT clearly. Please fill in blanks, underline or circle the correct answers. Send top three copies to Kansas Department of Health and Environment, Bureau of Water, Topeka, Kansas 66620-0001. Telephone: 913-296-5545. Send one to WATER WELL OWNER and retain one for your records.