

USE TYPEWRITER OR BALL POINT PEN-PRESS FIRMLY, PRINT CLEARLY.

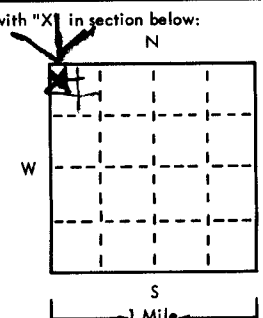
WATER WELL RECORD  
KSA 82a-1201-1215

B7B3  
NW NW NW

MT. JESUS

T R EW sec 1/4 1/4 1/4 No.

Kansas State Dept. Of Health  
(Water Well Contractors)  
Forbes-Bldg. 740  
Topeka, Kansas 66620

1 Location of well:	County <b>CLARK</b>	Township name <b>Leferton</b>	Fraction <b>NA</b>	Section number <b>5</b>	Town number <b>32S</b>	Range number <b>21W</b>
Distance and direction from nearest town or city: <b>22 SOUTH BUCKLIN</b>		3 Owner of well: <b>WILLIS HARDEN</b>				
Street address of well location if in city: <b>3/4 EAST</b>		Address: <b>ASHLAND TRANS</b>				
Locate with "X" in section below: 		Sketch map: <b>BUCKLIN</b> <b>Highway 22</b> <b>3/4 east</b>		4 Well depth: <b>115</b> ft. Date of completion <b>8/15/75</b> Well diameter <b>28</b> in.		
		5 <input type="checkbox"/> Cable tool <input type="checkbox"/> Rotary <input type="checkbox"/> Driven <input type="checkbox"/> Dug <input type="checkbox"/> Hollow rod <input type="checkbox"/> Jetted <input type="checkbox"/> Bored <input checked="" type="checkbox"/> Reverse rotary			6 Use: <input type="checkbox"/> Domestic <input type="checkbox"/> Public supply <input type="checkbox"/> Industry <input checked="" type="checkbox"/> Irrigation <input type="checkbox"/> Air conditioning <input type="checkbox"/> Commercial <input type="checkbox"/> Test well	
		7 Casing: Material <b>STEEL</b> Height: <b>above</b> below Threaded <input type="checkbox"/> Welded <input checked="" type="checkbox"/> Surface <b>60</b> in. Diam. <b>1 3/4</b> Weight <b>37</b> lbs./ft. <b>16</b> in. to <b>12</b> ft. depth Drive shoe? <input type="checkbox"/> Yes <input checked="" type="checkbox"/> No — in. to — ft. depth			8 Screen: Manufacturer <b>DOERR</b> Type <b>PUNCH</b> Dia. <b>1 1/2</b> " Slot/gauze <b>3/16</b> Length <b>40</b> Set between <b>35</b> ft. and <b>115</b> ft. Fittings: <b>1/4 x 5/8</b> Gravel pack <input checked="" type="checkbox"/> Yes <input type="checkbox"/> No Size range of material —	
2 Type and color of material		From	To	9 Static water level: <b>10</b> ft. below land surface Date <b>8/15/75</b>		
<b>TOPSOIL</b>		<b>0</b>	<b>10</b>	10 Pumping level below land surfaces: <b>80</b> ft. after <b>2</b> hrs. pumping <b>1000</b> g.p.m. — ft. after — hrs. pumping — g.p.m. Estimated maximum yield <b>1200</b> g.p.m.		
<b>SAND + CLAY</b>		<b>10</b>	<b>49</b>	11 Water sample submitted: <input type="checkbox"/> Yes <input checked="" type="checkbox"/> No Date —		
<b>BRACKEN Wood + LOOSE</b>		<b>49</b>	<b>115</b>	12 Well head completion: <input type="checkbox"/> Pitless adapter <input type="checkbox"/> Inches above grade		
<b>SHALE</b>		<b>115</b>		13 Well grouted? <input checked="" type="checkbox"/> Yes <input type="checkbox"/> No <input type="checkbox"/> Neat cement <input type="checkbox"/> Bentonite <input type="checkbox"/> Clay Depth: From <b>0</b> ft. to <b>16</b> ft.		
<b>BROCK 115</b>				14 Nearest source of possible contamination: <b>none</b> ft. — Direction — Type — Well disinfected upon completion? <input type="checkbox"/> Yes <input checked="" type="checkbox"/> No		
<b>10' set thick</b>				15 Pump: <input type="checkbox"/> Not installed Manufacturer's name <b>Fairbanks Morse</b> Model number <b>7006</b> HP <b>100</b> Volts — Length of drop pipe <b>100</b> ft. capacity <b>1000</b> g.p.m. Type: <input type="checkbox"/> Submersible <input checked="" type="checkbox"/> Turbine <input type="checkbox"/> Jet <input type="checkbox"/> Reciprocating <input type="checkbox"/> Centrifugal <input type="checkbox"/> Other		
<b>in Alluvium</b>				16 Remarks: elevation  Topography: <input type="checkbox"/> Hill <input checked="" type="checkbox"/> Flat <input type="checkbox"/> Slope <input type="checkbox"/> Upland <input type="checkbox"/> Valley <input type="checkbox"/> Valley		
<b>1998</b> <b>115</b> <b>1883'</b>				17 Water well contractor's certification: This well was drilled under my jurisdiction and this report is true to the best of my knowledge and belief. <b>BRACU Drilling Co 217</b> Business name License No. Address <b>BUCKLIN</b> Signed <b>Robert W. Baker</b> Date <b>7-18-75</b> Authorized representative		

32 21W 5 NW NW NW