USE TYPEWRITER OR BALL POINT PEN-PRESS FIRMLY, PRINT CLEARLY.

WATER WELL RECORD
KSA 82a-1201-1215

Kansas Department of Health and Environment-Division of Environment
(Water well Contractors)
Topeka, Kansas 66620

CWW Inv. #13873 DBD Caley #1-35

1. Location of well: County	Fraction	Section number	Township number	Range number
Clark	SE 1/4 NW 1/4 SE 1/4	35	T 32S S	R 21W E/W

2. Distance and direction from nearest town or city: From Ashland go 6m Ea. to Sitka jct. Then go 4m Ea.- 1m No. - ½m Ea. - ½m.No. to location.
Street address of well location if in city:

3. Owner of well: Rine Drilling Co.
R.R. or street: Box 1226
City, state, zip code: Woodward, Oklahoma 73801

4. Locate with "X" in section below:

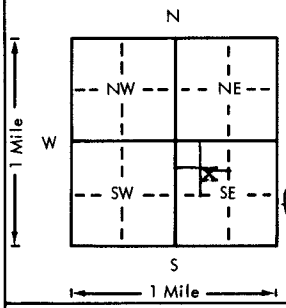

Sketch map:

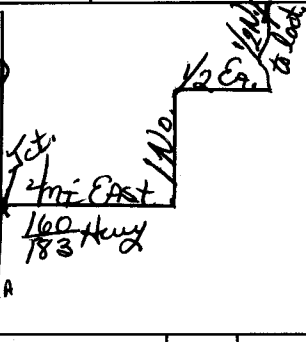

6. Bore hole dia. 9 in. Completion date 9-30-77
Well depth 200 ft.

7. __ Cable tool __ Rotary __ Driven __ Dug
__ Hollow rod X Jetted __ Bored __ Reverse rotary

8. Use: __ Domestic __ Public supply X Industry
__ Irrigation __ Air conditioning __ Stock
__ Lawn X Oil field water __ Other

9. Casing: Material _____ Height: Above or below
Threaded ____ Welded ____ Surface 28 in.
RMP ____ PVC X Weight 2.78 lbs./ft.
Dia. 5 in. to 20 ft. depth Wall Thickness: inches or
Dia. 5 in. to 200 ft. depth gage No. .265

10. Screen: Manufacturer's name Sawed perf.
Type PVC Dia. 5"
Slot/gauze .030 Length 180'
Set between 20 ft. and 200 ft.
____ ft. and ____ ft.
Gravel pack? yes Size range of material ____

5. Type and color of material	From	To
Surface	0	2
Fine sand 30% & Redbed	20	70
Fine sand 10% & Redbed	70	110
White rock	110	155
Fine sand 10% & Redbed	155	168
White rock	168	175
Redbed	175	200
B ROCK 70'		
15		
55' sat. thick		
Alluvium		
(Use a second sheet if needed)		

11. Static water level: mo./day/yr.
15 ft. below land surface Date 9-30-77

12. Pumping level below land surfaces:
____ ft. after ____ hrs. pumping ____ g.p.m.
____ ft. after ____ hrs. pumping ____ g.p.m.
Estimated maximum yield 60 g.p.m.

13. Water sample submitted: mo./day/yr.
__ Yes X No Date ____

14. Well head completion:
__ Pitless adapter 28 Inches above grade

15. Well grouted? yes
With: X Neat cement ____ Bentonite ____ Concrete
Depth: From 0 ft. to 10 ft.

16. Nearest source of possible contamination:
ft. 100 Direction NE Type oilwell
Well disinfected upon completion? X Yes ____ No

17. Pump: X Not installed
Manufacturer's name ____
Model number ____ HP ____ Volts ____
Length of drop pipe ____ ft. capacity ____ g.p.m.
Type:
__ Submersible __ Turbine
__ Jet __ Reciprocating
__ Centrifugal __ Other

18. Elevation:
Topography:
__ Hill
__ Slope
X Upland
__ Valley

19. Remarks:
TOPO
1867
70
1797

20. Water well contractor's certification:
This well was drilled under my jurisdiction and this report is true to the best of my knowledge and belief.
Carlile Water Well 118
Business name License No.
Address Box 275, Liberal, KS
Signed Edward E. Means Date 10/11/77
Authorized representative

32 21 W 35 CNE SE

Forward the white, blue and pink copies to the Department of Health and Environment

Form WWC-5

MI-1023