

**WATER WELL PLUGGING RECORD**

Form WWC-5P

KSA 82a-1212

ID No.


VP-39

<b>1 LOCATION OF WATER WELL:</b>	Fraction	Section Number	Township Number	Range Number
County: <u>Meade</u>	<u>NE 1/4 NW 1/4 NE 1/4</u>	<u>11</u>	<u>32S</u>	<u>28W</u>

Distance and direction from nearest town or city street address of well if located within city?  
623 E. Carthage, Meade, KS 67864

<b>2 WATER WELL OWNER:</b> <u>Meade Municipal Plant</u> RR#, St. Address, Box # <u>623 East Carthage St.</u> City, State, ZIP Code <u>Meade, KS 67864</u>	<b>Board of Agriculture, Division of Water Resources</b> Application Number:
---	---

**3 MARK WELL'S LOCATION WITH AN 'X' IN SECTION BOX:**

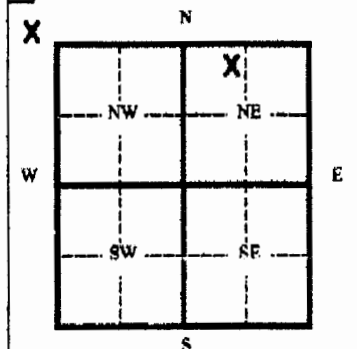

**4 DEPTH OF WELL** 19.8 ft.

WELL'S STATIC WATER LEVEL \_\_\_\_\_ ft.

- WELL WAS USED AS:
- |              |                              |                    |
|--------------|------------------------------|--------------------|
| 1 Domestic   | 5 Public Water Supply        | 9 Dewatering       |
| 2 Irrigation | 6 Oil Field Water Supply     | 10 Monitoring Well |
| 3 Feedlot    | 7 Lawn and Garden (domestic) | 11 Injection Well  |
| 4 Industrial | 8 Air Conditioning           | 12 Other _____     |

Was a chemical/bacteriological sample submitted to Department? Yes \_\_\_\_\_ No \_\_\_\_\_  
 If yes, mo/day/yr sample was submitted \_\_\_\_\_  
 Water Well Disinfected: Yes \_\_\_\_\_ No \_\_\_\_\_

**5 TYPE OF BLANK CASING USED:**

1 Steel	3 RMP (SR)	5 Wrought	7 Fiberglass	9 Other (specify below)
2 PVC	4 ABC	6 Asbestos-Cement	8 Concrete Tile	

Blank casing diameter 2 in. Was casing pulled? Yes  No \_\_\_\_\_ If yes, how much \_\_\_\_\_ 3 feet  
 Casing height above or below land surface \_\_\_\_\_ in.

**6 GROUT PLUG MATERIAL:** 1 Neat cement 2 Cement grout  3 Bentonite 4 Other \_\_\_\_\_

Grout Plug Intervals From \_\_\_\_\_ ft. to \_\_\_\_\_ ft. From \_\_\_\_\_ ft. to \_\_\_\_\_ ft. From \_\_\_\_\_ ft. to \_\_\_\_\_ ft.

- What is the nearest source of possible contamination:
- |                          |                   |                         |                          |
|--------------------------|-------------------|-------------------------|--------------------------|
| 1 Septic tank            | 6 Seepage pit     | 11 Fuel storage         | 16 Other (specify below) |
| 2 Sewer lines            | 7 Pit privy       | 12 Fertilizer storage   |                          |
| 3 Watertight sewer lines | 8 Sewage lagoon   | 13 Insecticide storage  |                          |
| 4 Lateral lines          | 9 Feedyard        | 14 Abandoned water well |                          |
| 5 Cess Pool              | 10 Livestock pens | 15 Oil well/ Gas well   |                          |
- Direction from well? \_\_\_\_\_ How many feet? \_\_\_\_\_

FROM	TO	CODE	PLUGGING MATERIALS
0	3'		Native
3'	19.8'		Bentonite Chips

**7 CONTRACTOR'S OR LANDOWNER'S CERTIFICATION:** This water well was plugged under my jurisdiction and was completed on (mo/day/yr) 3/26/14 and this record is true to the best of my knowledge and belief. Kansas Water Well Contractor's License No. 4/15/14 This Water Well Record was completed on (mo/day/yr) \_\_\_\_\_ under the business name of Bluestem Environmental Engineering, Inc. by (signature) Nick Hart

**INSTRUCTIONS:** Please fill in blanks and circle the correct answers. Send three copies to Kansas Department of Health and Environment, Bureau of Water, 1000 S W Jackson St., Ste. 420, Topeka, Kansas 66620-0001. Telephone: 785-296-3585. Send one to Water Well Owner and retain one for your records.