


1 LOCATION OF WATER WELL:	Fraction	Section Number	Township Number	Range Number
County: Clark	SW ¼ SW ¼ SE ¼	25	32	23 E/W

Distance and direction from nearest town or city street address of well if located within city?
 NNG Ashland Station, approx. 2.5 mi. N of Ashland

2 WATER WELL OWNER: NORTHERN NATURAL GAS 451 S. COUNTRY ESTATES ROAD RR #, St. Address, Box #: LIBERAL, KS 67901 City, State, ZIP Code :	Board of Agriculture, Division of Water Resources Application Number:
---	--------------------------------------------------------------------------

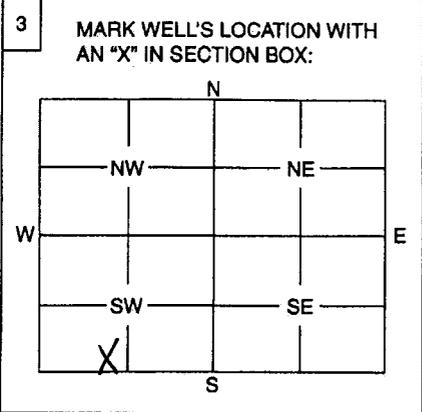

4 DEPTH OF WELL 36.15 ft.
 WELL'S STATIC WATER LEVEL 24 ft.

WELL WAS USED AS:

1 Domestic	5 Public Water Supply	9 Dewatering
2 Irrigation	6 Oil Field Water Supply	<input checked="" type="checkbox"/> Monitoring Well
3 Feedlot	7 Domestic (Lawn & Garden)	11 Injection Well
4 Industrial	8 Air Conditioning	12 Other

Was a chemical / bacteriological sample submitted to Department? Yes No
 If yes, mo/day/yr sample was submitted

Water Well Disinfected: Yes No

5 TYPE OF BLANK CASING USED:

1 Steel	3 RMP (SR)	5 Wrought	7 Fiberglass	9 Other (Specify below)
<input checked="" type="checkbox"/> PVC	4 ABS	6 Asbestos-Cement	8 Concrete Tile

Blank casing diameter 2 in. Was casing pulled? Yes No If yes, how much 16*

Casing height above or below land surface 36 in.

6 GROUT PLUG MATERIAL: 1 Neat cement 2 Cement grout Bentonite Other ..Native soil.....

Grout Plug Intervals: From 0 ft. to 1 ft., From 1 ft. to 36.15 ft., From to ft.

What is the nearest source of possible contamination:

1 Septic tank	6 Seepage pit	11 Fuel storage	16 Other (specify below)
2 Sewer lines	7 Pit privy	12 Fertilizer storage
3 Watertight sewer lines	8 Sewage lagoon	13 Insecticide storage	
4 Lateral lines	9 Feedyard	14 Abandoned water well	
5 Cess pool	10 Livestock pens	15 Oil well/Gas well	

Direction from well? How many feet?

FROM	TO	PLUGGING MATERIALS
0	1	Native soil
1	13	Bentonite (8")
13	36.15	Bentonite (2")

*Drilled out to 13' bgs
 MW7
 GeoCore #1308 (1084)

7 CONTRACTOR'S OF LANDOWNER'S CERTIFICATION: This water well was plugged under my jurisdiction and was completed on (mo/day/year) 7/13/2006 and this record is true to the best of my knowledge and belief. Kansas Water Well Contractor's License No. 527 This Water Well Record was completed on (mo/day/year) 7/25/2006 under the business name of Geocore, Inc.
 by (signature) *Outa Kelp*

INSTRUCTIONS: Use typewriter or ball point pen. Please press firmly and print clearly. Please fill in blanks, underline or circle the correct answers. Send top three copies to Kansas Department of Health and Environment, Bureau of Water, Geology Section, 1000 SW Jackson St., Ste. 420, Topeka, Kansas 66612-1367. Telephone: 785/296-5522. Send one to Water Well Owner and retain one for your records.