

County: Clark Fraction NE-NE Sec. 35 T 32 S R 23 E/W

CORRECTION(S) TO WATER WELL COMPLETION RECORD (WWC-5)

(to rectify lacking or incorrect information)

Owner: Spare, Randell

Location was listed as:

Section-Township-Range: _____

Fraction (1/4 1/4 1/4): NE-SE-SE-SE

Location changed to:

NE-NE

Other changes: Initial statements: _____

Changed to: _____

Comments: _____

Verification method: mapped lat/long

initials: DF date: 5/19/14

Submitted by: Kansas Geological Survey, Data Resources Library, 1930 Constant Ave., Lawrence, KS 66047-3726
to: Kansas Dept of Health & Environment, Bureau of Water, 1000 SW Jackson, Suite 420, Topeka, KS 66612-1367.

WATER WELL RECORD

Form WWC-5


Division of Water Resources App. No.

1 LOCATION OF WATER WELL: County: Clark	Fraction NE ¼ SE ¼ SE ¼ SE ¼	Section Number 35	Township No. T 32 S	Range Number R 23 <input type="checkbox"/> E <input checked="" type="checkbox"/> W
---	---------------------------------	----------------------	------------------------	---

Street/Rural Address of Well Location; if unknown, distance & direction from nearest town or intersection: If at owner's address, check here
1811 Co Rd 19, Ashland

Global Positioning System (GPS) information:
 Latitude: 37.13.180'..... (in decimal degrees)
 Longitude: 99.46.907'..... (in decimal degrees)
 Elevation: 1976.....
 Datum: WGS 84, NAD 83, NAD 27
 Collection Method:
 GPS unit (Make/Model: Garmin GPSmap60.....)
 Digital Map/Photo, Topographic Map, Land Survey
 Est. Accuracy: <3 m, 3-5 m, 5-15 m, >15 m

2 WATER WELL OWNER: Randell Spare
 RR#, Street Address, Box #: 604 W 4th Ave
 City, State, ZIP Code : Ashland, KS 67831

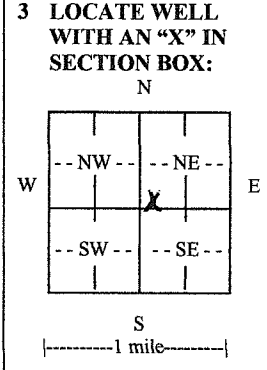

4 DEPTH OF COMPLETED WELL 135..... ft.
 Depth(s) Groundwater Encountered (1)..... ft. (2)..... ft. (3)..... ft.
 WELL'S STATIC WATER LEVEL 25.....ft. below land surface measured on mo/day/yr. 8/18/10.....
 Pump test data: Well water was 65.....ft. after 1..... hours pumping, 20..... gpm
 EST. YIELD 20.....gpm. Well water was.....ft. after..... hours pumping..... gpm
 Bore Hole Diameter 8 3/4.....in. to 135.....ft., and.....in. to.....ft.
 WELL WATER TO BE USED AS: Public water supply Geothermal Injection well
 Domestic Feedlot Oil field water supply Dewatering Other (Specify below)
 Irrigation Industrial Domestic-lawn & garden Monitoring well
 Was a chemical/bacteriological sample submitted to Department? Yes No
 If yes, mo/day/yr sample was submitted.....
 Water well disinfected? Yes No

5 TYPE OF CASING USED: Steel PVC Other
 CASING JOINTS: Glued Clamped Welded Threaded
 Casing diameter .5..... in. to .115..... ft., Diameter..... in. to..... ft., Diameter..... in. to..... ft.
 Casing height above land surface .18..... in., Weight.....lbs./ft., Wall thickness or gauge No. .2100#.....
 TYPE OF SCREEN OR PERFORATION MATERIAL:
 Steel Stainless Steel PVC Other (Specify)
 Brass Galvanized Steel None used (open hole)
 SCREEN OR PERFORATION OPENINGS ARE:
 Continuous slot Mill slot Gauze wrapped Torch cut Drilled holes None (open hole)
 Louvered shutter Key punched Wire wrapped Saw cut Other (specify)
 SCREEN-PERFORATED INTERVALS: From 115..... ft. to 135..... ft., From..... ft. to..... ft.
 GRAVEL PACK INTERVALS: From 24..... ft. to 135..... ft., From..... ft. to..... ft.
 From..... ft. to..... ft., From..... ft. to..... ft.

6 GROUT MATERIAL: Neat cement Cement grout Bentonite Other
 Grout Intervals: From 4..... ft. to 24..... ft., From..... ft. to..... ft., From..... ft. to..... ft.
 What is the nearest source of possible contamination:
 Septic tank Lateral lines Pit privy Livestock pens Insecticide storage Other (specify below)
 Sewer lines Cesspool Sewage lagoon Fuel storage Abandoned water well
 Watertight sewer lines Seepage pit Feedyard Fertilizer storage Oil well/gas well
 Direction from well South..... Distance from well 60'.....

FROM	TO	LITHOLOGIC LOG	FROM	TO	LITHO. LOG (cont.) or PLUGGING INTERVALS
0	8	sand			
8	40	brown clay			
40	65	sandy brown clay			
65	75	red clay			
75	90	red clay w/liver mud			
90	130	red clay			
130	135	red sand			

7 CONTRACTOR'S OR LANDOWNER'S CERTIFICATION: This water well was constructed, reconstructed, or plugged under my jurisdiction and was completed on (mo/day/year) 8/20/2010..... and this record is true to the best of my knowledge and belief. Kansas Water Well Contractor's License No. 101..... This Water Well Record was completed on (mo/day/year) 9/30/2010..... under the business name of Bartel Well Drilling, Inc..... by (signature) Randell Spare.....

INSTRUCTIONS: Use typewriter or ball point pen. PLEASE PRESS FIRMLY and PRINT clearly. Please fill in blanks and check the correct answers. Send three copies (white, blue, pink) to Kansas Department of Health and Environment, Bureau of Water, Geology Section, 1000 SW Jackson St., Suite 420, Topeka, Kansas 66612-1367. Telephone 785-296-5522. Send one copy to WATER WELL OWNER and retain one for your records. Include fee of \$5.00 for each constructed well. Visit us at <http://www.kdheks.gov/waterwell/index.html>.