


1 LOCATION OF WATER WELL: Fraction SE 1/4 SE 1/4 SW 1/4 Section Number 8 Township Number T 32 S Range Number R 23 E/W
 County: CLARK

Distance and direction from nearest town or city street address of well if located within city?
 4 North, 3 1/2 West of Ashland, Kansas

2 WATER WELL OWNER: Cooper & Herrmann
 RR#, St. Address, Box #: 9415 E. Harry, Suite #306 Board of Agriculture, Division of Water Resources
 City, State, ZIP Code: Wichita, KS 67207 Application Number: ---

3 LOCATE WELL'S LOCATION WITH AN "X" IN SECTION BOX:

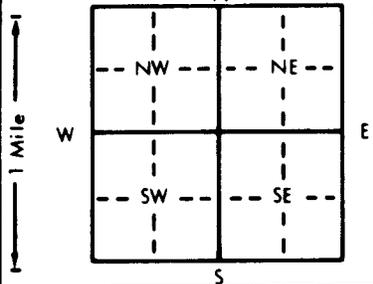

4 DEPTH OF COMPLETED WELL: 217 ft. ELEVATION: Slope
 Depth(s) Groundwater Encountered: 1. Not available ft. 2. ft. 3. ft.
 WELL'S STATIC WATER LEVEL: 50 ft. below land surface measured on mo/day/yr July 25, 1991
 Pump test data: Well water was ft. after hours pumping gpm
 Est. Yield: 30 gpm; Well water was ft. after hours pumping gpm
 Bore Hole Diameter: 10 in. to 217 ft., and in. to ft.
 WELL WATER TO BE USED AS:
 Domestic 3 Feedlot 6 Oil field water supply 9 Dewatering 12 Other (Specify below)
 2 Irrigation 4 Industrial 7 Lawn and garden only 10 Monitoring well
 Was a chemical/bacteriological sample submitted to Department? Yes No If yes, mo/day/yr sample was submitted
 Water Well Disinfected? Yes No

5 TYPE OF BLANK CASING USED:
 1 Steel 3 RMP (SR) 5 Wrought iron 8 Concrete tile CASING JOINTS: Glued Clamped
 PVC 4 ABS 6 Asbestos-Cement 9 Other (specify below) Welded
 7 Fiberglass Threaded
 Blank casing diameter: 5 in. to 80 ft., Dia. in. to ft., Dia. in. to ft.
 Casing height above land surface: 20 in., weight: 2.8 lbs./ft. Wall thickness or gauge No. 265
 TYPE OF SCREEN OR PERFORATION MATERIAL: PVC 10 Asbestos-cement
 1 Steel 3 Stainless steel 5 Fiberglass 8 RMP (SR) 11 Other (specify)
 2 Brass 4 Galvanized steel 6 Concrete tile 9 ABS 12 None used (open hole)
 SCREEN OR PERFORATION OPENINGS ARE:
 1 Continuous slot 3 Mill slot 5 Gauzed wrapped Saw cut 11 None (open hole)
 2 Louvered shutter 4 Key punched 6 Wire wrapped 9 Drilled holes
 7 Torch cut 10 Other (specify)
 SCREEN-PERFORATED INTERVALS: From 80 ft. to 220 ft., From ft. to ft.
 From ft. to ft., From ft. to ft.
 GRAVEL PACK INTERVALS: From 30 ft. to 220 ft., From ft. to ft.
 From ft. to ft., From ft. to ft.

6 GROUT MATERIAL: 1 Neat cement 2 Cement grout Bentonite 4 Other
 Grout Intervals: From 0 ft. to 30 ft., From ft. to ft., From ft. to ft.
 What is the nearest source of possible contamination:
 Septic tank 4 Lateral lines 7 Pit privy 10 Livestock pens 14 Abandoned water well
 2 Sewer lines 5 Cess pool 8 Sewage lagoon 11 Fuel storage 15 Oil well/Gas well
 3 Watertight sewer lines 6 Seepage pit 9 Feedyard 12 Fertilizer storage 16 Other (specify below)
 13 Insecticide storage
 Direction from well? West How many feet? 500

FROM	TO	LITHOLOGIC LOG	FROM	TO	Lithologic LOG
0	2	Topsoil	155	180	Red Bed
2	11	Clay	180	183	Liver Mud
11	31	Med. Sand	183	200	Red Bed
31	80	Red Bed	200	207	Soft LiverMud
80	85	Liver Mud	207	215	Hard Rock
85	95	Red Bed	215	220	Gypsum
95	97	Liver Mud			
97	110	Red Bed			
110	114	LiverMud			
114	121	Red Bed			
122	129	Liver Mud			
129	135	Red Bed			
135	137	Liver Mud			
137	150	Red Bed			
150	155	Liver Mud			

7 CONTRACTOR'S OR LANDOWNER'S CERTIFICATION: This water well was (1) constructed, (2) reconstructed, or (3) plugged under my jurisdiction and was completed on (mo/day/year) August 6, 1991 and this record is true to the best of my knowledge and belief. Kansas Water Well Contractor's License No. 252 This Water Well Record was completed on (mo/day/year) August 7, 1991 under the business name of Friesen Windmill & Supply Inc. by signature

INSTRUCTIONS: Use typewriter or ball point pen. PLEASE PRESS FIRMLY and PRINT clearly. Please fill in blanks, underline or circle the correct answers. Send top three copies to Kansas Department of Health and Environment, Bureau of Water, Topeka, Kansas 66620-7320. Telephone: 913-296-5545. Send one to WATER WELL OWNER and retain one for your records.

22-9001260297

OFFICE USE ONLY
T
R
EW
SEC.