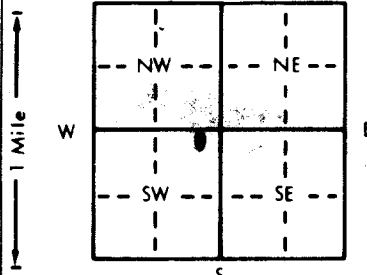


1 LOCATION OF WATER WELL: County: Clark Fraction: NE 1/4 NE 1/4 SW 1/4 Section Number: 6 Township Number: T 32 S Range Number: R 24 E

Distance and direction from nearest town or city street address of well if located within city?  
12 W + 1 N from Ashland

2 WATER WELL OWNER: Duane Mooreman  
RR#, St. Address, Box #: Ashland, KS 67831  
City, State, ZIP Code: Ashland, KS 67831  
Board of Agriculture, Division of Water Resources  
Application Number:

3 LOCATE WELL'S LOCATION WITH AN "X" IN SECTION BOX:  
 4 DEPTH OF COMPLETED WELL: 160 ft. ELEVATION:  
Depth(s) Groundwater Encountered 1. ? ft. 2. ? ft. 3. ? ft.  
WELL'S STATIC WATER LEVEL: 112 ft. below land surface measured on mo/day/yr 7-8-91  
Pump test data: Well water was 150 ft. after 1 hours pumping 3 gpm  
Est. Yield 3 gpm; Well water was 150 ft. after 1 hours pumping 3 gpm  
Bore Hole Diameter: 8 3/4 in. to 160 ft., and ? in. to ? ft.  
WELL WATER TO BE USED AS: 5 Public water supply 8 Air conditioning 11 Injection well  
 Domestic 3 Feedlot 6 Oil field water supply 9 Dewatering 12 Other (Specify below)  
2 Irrigation 4 Industrial 7 Lawn and garden only 10 Monitoring well  
Was a chemical/bacteriological sample submitted to Department? Yes ? No  If yes, mo/day/yr sample was submitted  
Water Well Disinfected? Yes  No

5 TYPE OF BLANK CASING USED:  
1 Steel 3 RMP (SR) 6 Asbestos-Cement 9 Other (specify below)  
 PVC 4 ABS 7 Fiberglass  
Blank casing diameter: 5 in. to 100 ft., Dia. ? in. to ? ft., Dia. ? in. to ? ft.  
Casing height above land surface: 10 in., weight ? lbs./ft. Wall thickness or gauge No. 20016  
TYPE OF SCREEN OR PERFORATION MATERIAL:  
1 Steel 3 Stainless steel 5 Fiberglass 8 RMP (SR) 10 Asbestos-cement  
2 Brass 4 Galvanized steel 6 Concrete tile 9 ABS 11 Other (specify) 12 None used (open hole)  
SCREEN OR PERFORATION OPENINGS ARE:  
1 Continuous slot 3 Mill slot 5 Gauzed wrapped  Saw cut 11 None (open hole)  
2 Louvered shutter 4 Key punched 6 Wire wrapped 9 Drilled holes  
7 Torch cut 10 Other (specify)  
SCREEN-PERFORATED INTERVALS: From 100 ft. to 160 ft., From ? ft. to ? ft.  
GRAVEL PACK INTERVALS: From 20 ft. to 16 ft., From ? ft. to ? ft.

6 GROUT MATERIAL: 1 Neat cement  Cement grout 3 Bentonite 4 Other  
Grout intervals: From top ft. to 20 ft., From ? ft. to ? ft., From ? ft. to ? ft.  
What is the nearest source of possible contamination:  
1 Septic tank 4 Lateral lines 7 Pit privy 10 Livestock pens 14 Abandoned water well  
2 Sewer lines 5 Cess pool 8 Sewage lagoon 11 Fuel storage 15 Oil well/Gas well  
3 Watertight sewer lines 6 Seepage pit 9 Feedyard 12 Fertilizer storage 16 Other (specify below)  
13 Insecticide storage Creek  
Direction from well? NW How many feet? 1400

FROM	TO	LITHOLOGIC LOG	FROM	TO	PLUGGING INTERVALS
<u>0</u>	<u>5</u>	<u>Top soil</u>			
<u>5</u>	<u>60</u>	<u>white sandy clay</u>			
<u>60</u>	<u>160</u>	<u>blue clay</u>			

7 CONTRACTOR'S OR LANDOWNER'S CERTIFICATION: This water well was  constructed, (2) reconstructed, or (3) plugged under my jurisdiction and was completed on (mo/day/year) 7-9-91 and this record is true to the best of my knowledge and belief. Kansas Water Well Contractor's License No. 101A This Water Well Record was completed on (mo/day/yr) 7-9-91 under the business name of Bartel Well Drilling by (signature) Reuben J. Bartel

OFFICE USE ONLY  
T  
R  
EM  
SEC.