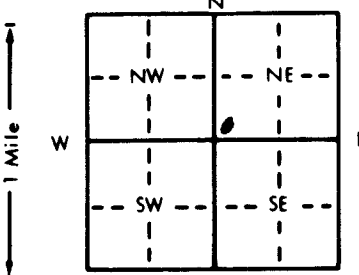


1 LOCATION OF WATER WELL: County: Clark Fraction: SW 1/4 SW 1/4 NE 1/4 Section Number: 30 Township Number: T 32 S Range Number: R 25 EW

Distance and direction from nearest town or city street address of well if located within city?
12 1/2 N and 5 1/2 W of Englewood.

2 WATER WELL OWNER: Dave Green
 RR#, St. Address, Box #: 1/2 Bill Roberts Board of Agriculture, Division of Water Resources
 City, State, ZIP Code: Fowler, KS 67844 Application Number:

3 LOCATE WELL'S LOCATION WITH AN "X" IN SECTION BOX:

 4 DEPTH OF COMPLETED WELL: 131 ft. ELEVATION:
 Depth(s) Groundwater Encountered 1. 106 ft. 2. ft. 3. ft.
 WELL'S STATIC WATER LEVEL: 60 ft. below land surface measured on mo/day/yr
 Pump test data: Well water was 60 ft. after 1 hours pumping 15 gpm
 Est. Yield 20 gpm; Well water was ft. after hours pumping gpm
 Bore Hole Diameter: 8 3/4 in. to 131 ft., and in. to ft.
 WELL WATER TO BE USED AS:
 Domestic 3 Feedlot 6 Oil field water supply 9 Dewatering 12 Other (Specify below)
 2 Irrigation 4 Industrial 7 Lawn and garden only 10 Monitoring well
 Was a chemical/bacteriological sample submitted to Department? Yes.....No..... If yes, mo/day/yr sample was submitted
 Water Well Disinfected? Yes No

5 TYPE OF BLANK CASING USED:
 1 Steel 3 RMP (SR) 5 Wrought iron 8 Concrete tile CASING JOINTS: Glued Clamped.....
 PVC 4 ABS 7 Fiberglass 9 Other (specify below) Welded.....
 Blank casing diameter 5 in. to 91 ft., Dia. in. to ft., Dia. in. to ft.
 Casing height above land surface: 24 in., weight lbs./ft. Wall thickness or gauge No. 20016
 TYPE OF SCREEN OR PERFORATION MATERIAL:
 Steel 3 Stainless steel 5 Fiberglass 8 RMP (SR) 10 Asbestos-cement
 2 Brass 4 Galvanized steel 6 Concrete tile 9 ABS 12 None used (open hole)
 SCREEN OR PERFORATION OPENINGS ARE:
 1 Continuous slot 3 Mill slot 5 Gauzed wrapped Saw cut 11 None (open hole)
 2 Louvered shutter 4 Key punched 6 Wire wrapped 9 Drilled holes
 7 Torch cut 10 Other (specify)
 SCREEN-PERFORATED INTERVALS: From 91 ft. to 131 ft., From ft. to ft.
 From ft. to ft., From ft. to ft.
 GRAVEL PACK INTERVALS: From 20 ft. to 131 ft., From ft. to ft.
 From ft. to ft., From ft. to ft.

6 GROUT MATERIAL: 1 Neat cement 2 Cement grout Bentonite 4 Other.....
 Grout Intervals: From top ft. to 20 ft., From ft. to ft., From ft. to ft.
 What is the nearest source of possible contamination:
 1 Septic tank 4 Lateral lines 7 Pit privy 10 Livestock pens 14 Abandoned water well
 2 Sewer lines 5 Cess pool 8 Sewage lagoon 11 Fuel storage 15 Oil well/Gas well
 3 Watertight sewer lines 6 Seepage pit 9 Feedyard 12 Fertilizer storage 16 Other (specify below)
 13 Insecticide storage
 Direction from well? E How many feet? 20

FROM	TO	LITHOLOGIC LOG	FROM	TO	PLUGGING INTERVALS
0	10	top soil			
10	30	white clay			
30	100	sand + gravel			
100	106	brown clay			
106	120	sand + gravel			
120	131	sandy red clay			

7 CONTRACTOR'S OR LANDOWNER'S CERTIFICATION: This water well was constructed, (2) reconstructed, or (3) plugged under my jurisdiction and was completed on (mo/day/year) 5-14-93 and this record is true to the best of my knowledge and belief. Kansas Water Well Contractor's License No. 101 This Water Well Record was completed on (mo/day/year) 5-24-93 under the business name of Bartel Well Drilling, Inc. by (signature) Ruben J. Bartel

INSTRUCTIONS: Use typewriter or ball point pen. PLEASE PRESS FIRMLY and PRINT clearly. Please fill in blanks, underline or circle the correct answers. Send top three copies to Kansas Department of Health and Environment, Bureau of Water, Topeka, Kansas 66620-0001. Telephone: 913-296-5545. Send one to WATER WELL OWNER and retain one for your records.

OFFICE USE ONLY
T
R
EW
SEC.
1/4
1/4
1/4