


1 LOCATION OF WATER WELL: County: Meade Fraction: SW 1/4 NE 1/4 SE 1/4 Section Number: 16 Township Number: T 32 S Range Number: R 26 E

Distance and direction from nearest town or city street address of well if located within city?
10E and 2S of Meade

2 WATER WELL OWNER: Bob Laupde
RR#, St. Address, Box # : _____ Board of Agriculture, Division of Water Resources
City, State, ZIP Code : Fowler, KS 67844 Application Number: _____

3 LOCATE WELL'S LOCATION WITH AN "X" IN SECTION BOX:

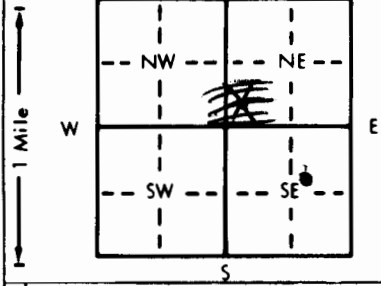

4 DEPTH OF COMPLETED WELL: 130 ft. ELEVATION: _____
Depth(s) Groundwater Encountered 1. 75 ft. 2. _____ ft. 3. _____ ft.
WELL'S STATIC WATER LEVEL: 70 ft. below land surface measured on mo/day/yr 5-24-89
Pump test data: Well water was 70 ft. after 1 hours pumping 20 gpm
Est. Yield 30 gpm; Well water was _____ ft. after _____ hours pumping _____ gpm
Bore Hole Diameter: 8 3/4 in. to 130 ft., and _____ in. to _____ ft.
WELL WATER TO BE USED AS:
 Domestic 3 Feedlot 6 Oil field water supply 9 Dewatering 12 Other (Specify below)
 2 Irrigation 4 Industrial 7 Lawn and garden only 10 Monitoring well
Was a chemical/bacteriological sample submitted to Department? Yes _____ No ; If yes, mo/day/yr sample was submitted _____
Water Well Disinfected? Yes No _____

5 TYPE OF BLANK CASING USED:
1 Steel 3 RMP (SR) 5 Wrought iron 8 Concrete tile CASING JOINTS: Glued Clamped _____
 PVC 4 ABS 6 Asbestos-Cement 9 Other (specify below) Welded _____
Blank casing diameter: 5 in. to 90 ft., Dia _____ in. to _____ ft., Dia _____ in. to _____ ft.
Casing height above land surface: 24 in., weight _____ lbs./ft. Wall thickness or gauge No. 2001b

TYPE OF SCREEN OR PERFORATION MATERIAL:
1 Steel 3 Stainless steel 5 Fiberglass 8 RMP (SR) 10 Asbestos-cement
2 Brass 4 Galvanized steel 6 Concrete tile 9 ABS 11 Other (specify) _____
12 None used (open hole)
SCREEN OR PERFORATION OPENINGS ARE:
1 Continuous slot 3 Mill slot 5 Gauzed wrapped Saw cut 11 None (open hole)
2 Louvered shutter 4 Key punched 6 Wire wrapped 9 Drilled holes
7 Torch cut 10 Other (specify) _____
SCREEN-PERFORATED INTERVALS: From 90 ft. to 130 ft., From _____ ft. to _____ ft.
From _____ ft. to _____ ft., From _____ ft. to _____ ft.
GRAVEL PACK INTERVALS: From 20 ft. to 130 ft., From _____ ft. to _____ ft.
From _____ ft. to _____ ft., From _____ ft. to _____ ft.

6 GROUT MATERIAL: 1 Neat cement Cement grout 3 Bentonite 4 Other _____
Grout Intervals: From top ft. to 20 ft., From _____ ft. to _____ ft., From _____ ft. to _____ ft.
What is the nearest source of possible contamination:
1 Septic tank 4 Lateral lines 7 Pit privy 10 Livestock pens 14 Abandoned water well
2 Sewer lines 5 Cess pool 8 Sewage lagoon 11 Fuel storage 15 Oil well/Gas well
3 Watertight sewer lines 6 Seepage pit 9 Feedyard 12 Fertilizer storage 16 Other (specify below) Swamp Creek
13 Insecticide storage

Direction from well? SW How many feet? 1000

FROM	TO	LITHOLOGIC LOG	FROM	TO	PLUGGING INTERVALS
top	8	top soil			
8	50	sandy clay			
50	75	white clay			
75	130	sand & gravel			
SDR-21					

7 CONTRACTOR'S OR LANDOWNER'S CERTIFICATION: This water well was constructed, (2) reconstructed, or (3) plugged under my jurisdiction and was completed on (mo/day/year) 5-25-89 and this record is true to the best of my knowledge and belief. Kansas Water Well Contractor's License No. 101A. This Water Well Record was completed on (mo/day/yr) 5-25-89 under the business name of Bartel Well Drilling by (signature) Reuben Bartel

INSTRUCTIONS: Use typewriter or ball point pen. PLEASE PRESS FIRMLY and PRINT clearly. Please fill in blanks, underline or circle the correct answers. Send top three copies to Kansas Department of Health and Environment, Bureau of Water Protection, Topeka, Kansas 66620-7320. Telephone: 913-296-5514. Send one to WATER WELL OWNER and retain one for your records.