


1 LOCATION OF WATER WELL: County: **Meade** Fraction: **SE 1/4 NW 1/4 SE 1/4** Section Number: **27** Township Number: **T 32 S** Range Number: **R 26** **EW**

Distance and direction from nearest town or city street address of well if located within city?
9 East, 3 1/2 South, 3/4 East of Meade, Kansas

2 WATER WELL OWNER: **Eva Hawkins**
 RR#, St. Address, Box #: **Fowler, Kansas 67844**
 City, State, ZIP Code: **Fowler, Kansas 67844**
 Board of Agriculture, Division of Water Resources
 Application Number: **---**

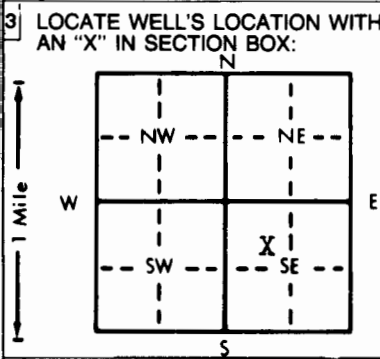

4 DEPTH OF COMPLETED WELL: **160** ft. ELEVATION: **Slope**
 Depth(s) Groundwater Encountered: **1 Not available** ft. 2. ft. 3. ft.
 WELL'S STATIC WATER LEVEL: **40** ft. below land surface measured on mo/day/yr **July 22, 1988**
 Pump test data: Well water was ft. after hours pumping gpm
 Est. Yield: **20** gpm: Well water was ft. after hours pumping gpm
 Bore Hole Diameter: **10** in. to **160** ft., and in. to ft.
 WELL WATER TO BE USED AS:
 Domestic 3 Feedlot 6 Oil field water supply 9 Dewatering 12 Other (Specify below)
 2 Irrigation 4 Industrial 7 Lawn and garden only 10 Observation well
 Was a chemical/bacteriological sample submitted to Department? Yes..... No **XX**.....; If yes, mo/day/yr sample was submitted
 Water Well Disinfected? Yes **XX** No

5 TYPE OF BLANK CASING USED:
 1 Steel 3 RMP (SR) 5 Wrought iron 8 Concrete tile CASING JOINTS: Glued **XX** Clamped
 2 PVC 4 ABS 6 Asbestos-Cement 9 Other (specify below) Welded
 7 Fiberglass Threaded
 Blank casing diameter: **5** in. to **60** ft., Dia in. to ft., Dia in. to ft.
 Casing height above land surface: **24** in., weight **2.8** lbs./ft. Wall thickness or gauge No. **265**
 TYPE OF SCREEN OR PERFORATION MATERIAL:
 PVC 10 Asbestos-cement
 1 Steel 3 Stainless steel 5 Fiberglass 8 RMP (SR) 11 Other (specify)
 2 Brass 4 Galvanized steel 6 Concrete tile 9 ABS 12 None used (open hole)
 SCREEN OR PERFORATION OPENINGS ARE:
 1 Continuous slot 3 Mill slot 5 Gauzed wrapped **XXX** Saw cut 11 None (open hole)
 2 Louvered shutter 4 Key punched 6 Wire wrapped 9 Drilled holes
 7 Torch cut 10 Other (specify)
 SCREEN-PERFORATED INTERVALS: From **60** ft. to **160** ft., From ft. to ft.
 From ft. to ft., From ft. to ft.
 GRAVEL PACK INTERVALS: From **21** ft. to **160** ft., From ft. to ft.
 From ft. to ft., From ft. to ft.

6 GROUT MATERIAL: 1 Neat cement 2 Cement grout 3 Bentonite **XXX** Other: **Baroid Hole Plug**
 Grout Intervals: From **0** ft. to **21** ft., From ft. to ft., From ft. to ft.
 What is the nearest source of possible contamination: **NONE**
 1 Septic tank 4 Lateral lines 7 Pit privy 10 Livestock pens 14 Abandoned water well
 2 Sewer lines 5 Cess pool 8 Sewage lagoon 11 Fuel storage 15 Oil well/Gas well
 3 Watertight sewer lines 6 Seepage pit 9 Feedyard 12 Fertilizer storage 16 Other (specify below)
 13 Insecticide storage

Direction from well? How many feet?

FROM	TO	LITHOLOGIC LOG	FROM	TO	LITHOLOGIC LOG
0	2	Topsoil	155	160	Red Bed
2	11	Clay			
11	19	Fine Sand			
19	23	Clay			
23	48	Fine Sand			
48	55	Red Bed			
55	58	Fine Sand & Red BED			
58	71	Red Bed			
71	78	Fine Sand & Gravel			
78	81	Red Bed			
81	85	Fine Sand & Gravel			
85	105	Red Bed			
105	116	Limestone			
116	130	Red Bed			
130	155	Fine Sand & Gravel			

7 CONTRACTOR'S OR LANDOWNER'S CERTIFICATION: This water well was (1) constructed, (2) reconstructed, or (3) plugged under my jurisdiction and was completed on (mo/day/year) **August 4, 1988** and this record is true to the best of my knowledge and belief. Kansas Water Well Contractor's License No. **252** This Water Well Record was completed on (mo/day/yr) **September 19, 1988** under the business name of **FRIESEN WINDMILL & SUPPLY INC.** by (signature)

INSTRUCTIONS: Use typewriter or ball point pen. PLEASE PRESS FIRMLY and PRINT clearly. Please fill in blanks, underline or circle the correct answers. Send top three copies to Kansas Department of Health and Environment, Bureau of Water Protection, Topeka, Kansas 66620-7320, Telephone: 913-862-9360. Send one to WATER WELL OWNER and retain one for your records.

50700000/2-01