

WATER WELL RECORD

Form WWC-5

1317096

Division of Water Resources App. No.

[]


Well ID

[]

- Original Record, Correction, Change in Well Use

1 LOCATION OF WATER WELL: County, Fraction, Section Number, Township Number, Range Number

2 WELL OWNER: Last Name, Business, Address, City, State, ZIP, Street or Rural Address

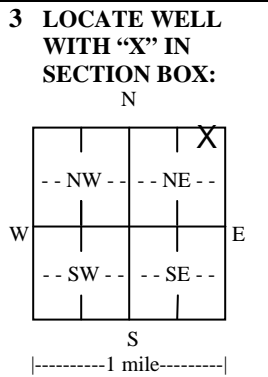

4 DEPTH OF COMPLETED WELL: Depth(s) Groundwater Encountered, WELL'S STATIC WATER LEVEL, Pump test data, Estimated Yield, Bore Hole Diameter

5 Latitude, Longitude, Datum, Source for Latitude/Longitude, GPS, Land Survey, Topographic Map, Online Mapper

6 Elevation, Ground Level, TOC, Source, Land Survey, GPS, Topographic Map, Other

7 WELL WATER TO BE USED AS: Domestic, Irrigation, Industrial, Public Water Supply, Dewatering, Aquifer Recharge, Monitoring, Environmental Remediation, Oil Field Water Supply, Test Hole, Geothermal

Was a chemical/bacteriological sample submitted to KDHE? Water well disinfected?

8 TYPE OF CASING USED, CASING JOINTS, Casing diameter, Casing height, TYPE OF SCREEN OR PERFORATION MATERIAL, SCREEN OR PERFORATION OPENINGS ARE, SCREEN-PERFORATED INTERVALS, GRAVEL PACK INTERVALS

9 GROUT MATERIAL: Neat cement, Cement grout, Bentonite, Other, Grout Intervals, Nearest source of possible contamination

Table with columns: FROM, TO, LITHOLOGIC LOG, FROM, TO, LITHO. LOG (cont.) or PLUGGING INTERVALS. Includes a Notes section.

11 CONTRACTOR'S OR LANDOWNER'S CERTIFICATION: This water well was constructed, reconstructed, or plugged under my jurisdiction...