

CORRECTION(S) TO WATER WELL RECORD (WWC-5)
(to rectify lacking or incorrect information)

County: Meade

Location listed as:

Section-Township-Range: 7-32S-37W

Fraction ($\frac{1}{4}$ $\frac{1}{4}$ $\frac{1}{4}$): NW NW NW

Location changed to:

7-32S-27W

NW NW NW

Other changes: Initial statements: _____

Changed to: _____

Comments: _____

verification method: written & legal descriptions, position on plat map,
and mapping tool & aerial photos on KGS website.

initials: DRL date: 8/23/2010

submitted by: Kansas Geological Survey, Data Resources Library, 1930 Constant Ave., Lawrence, KS 66047-3726
to: Kansas Dept of Health & Environment, Bureau of Water, 1000 SW Jackson, Suite 420, Topeka, KS 66612-1367.


1 LOCATION OF WATER WELL: County: Meade Fraction: NW 1/4 NW 1/4 NW 1/4 Section Number: 7 Township Number: T 32 S Range Number: R 37 E/W

Distance and direction from nearest town or city street address of well if located within city?

1 E of Meade, KS--

2 WATER WELL OWNER: Friesen Windmill & Supply RR#, St. Address, Box #: Drawer M City, State, ZIP Code: Meade, KS 67864 George S. Isaac Board of Agriculture, Division of Water Resources Application Number:

3 LOCATE WELL'S LOCATION WITH AN "X" IN SECTION BOX:

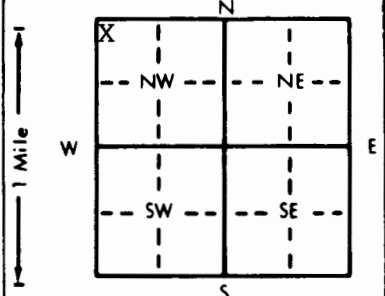

4 DEPTH OF COMPLETED WELL: 260 ft. ELEVATION: Depth(s) Groundwater Encountered: 1. 80 ft. 2. ft. 3. ft. WELL'S STATIC WATER LEVEL: 80 ft. below land surface measured on mo/day/yr: 11/22/93 Pump test data: Well water was 80 ft. after 1 hours pumping 22 gpm Est. Yield: 22 gpm: Well water was ft. after hours pumping gpm Bore Hole Diameter: 9.5 in. to 260 ft., and in. to ft. WELL WATER TO BE USED AS: 1 Domestic 3 Feedlot 6 Oil field water supply 9 Dewatering 12 Other (Specify below) 2 Irrigation 4 Industrial 7 Lawn and garden only 10 Monitoring well Was a chemical/bacteriological sample submitted to Department? Yes No X; If yes, mo/day/yr sample was submitted Water Well Disinfected? Yes X No

5 TYPE OF BLANK CASING USED: 1 Steel 3 RMP (SR) 5 Wrought iron 8 Concrete tile CASING JOINTS: Glued X Clamped Welded Threaded 2 PVC 4 ABS 7 Fiberglass 9 Other (specify below) 10 Asbestos-cement Blank casing diameter: 5 in. to 260 ft., Dia. in. to ft., Dia. in. to ft. Casing height above land surface: 24 in., weight: 2.902 lbs./ft. Wall thickness or gauge No.: 280 SDR21

TYPE OF SCREEN OR PERFORATION MATERIAL: 1 Steel 3 Stainless steel 5 Fiberglass 8 RMP (SR) 10 Asbestos-cement 2 Brass 4 Galvanized steel 6 Concrete tile 9 ABS 11 Other (specify) 12 None used (open hole)

SCREEN OR PERFORATION OPENINGS ARE: 1 Continuous slot 3 Mill slot 5 Gauzed wrapped 8 Saw cut 11 None (open hole) 2 Louvered shutter 4 Key punched 6 Wire wrapped 9 Drilled holes 7 Torch cut 10 Other (specify)

SCREEN-PERFORATED INTERVALS: From 160 ft. to 260 ft. GRAVEL PACK INTERVALS: From 110 ft. to 260 ft.

6 GROUT MATERIAL: 1 Neat cement 2 Cement grout 3 Bentonite 4 Other Hole Plug Grout Intervals: From 1 ft. to 20 ft.

What is the nearest source of possible contamination: 1 Septic tank 4 Lateral lines 7 Pit privy 10 Livestock pens 14 Abandoned water well 2 Sewer lines 5 Cess pool 8 Sewage lagoon 11 Fuel storage 15 Oil well/Gas well 3 Watertight sewer lines 6 Seepage pit 9 Feedyard 12 Fertilizer storage 16 Other (specify below) 13 Insecticide storage

Direction from well? How many feet?

FROM	TO	LITHOLOGIC LOG	FROM	TO	PLUGGING INTERVALS
0	10	Top Soil			
10	155	Clay and Sandy Clay			
155	200	Fine to Coarse Sand			
200	220	Sandy Clay			
220	260	Some sand streaks & Brown to Blue Clay			

7 CONTRACTOR'S OR LANDOWNER'S CERTIFICATION: This water well was (1) constructed, (2) reconstructed, or (3) plugged under my jurisdiction and was completed on (mo/day/year) 11/22/93 and this record is true to the best of my knowledge and belief. Kansas Water Well Contractor's License No. KWWCL-430 This Water Well Record was completed on (mo/day/yr) 11/22/93 under the business name of Howard Drilling Co. Box 806 Beaver, OK 73932 Signature: [Handwritten Signature]

INSTRUCTIONS: Use typewriter or ball point pen. PLEASE PRESS FIRMLY and PRINT clearly. Please fill in blanks, underline or circle the correct answers. Send top three copies to Kansas Department of Health and Environment, Bureau of Water, Topeka, Kansas 66620-0001. Telephone: 913-296-5545. Send one to WATER WELL OWNER and retain one for your records.