

USE TYPEWRITER OR BALL POINT PEN-PRESS FIRMLY, PRINT CLEARLY.

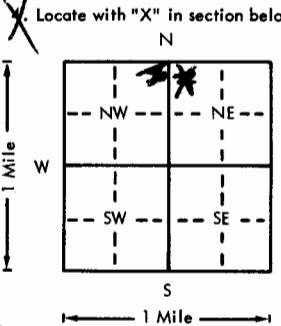
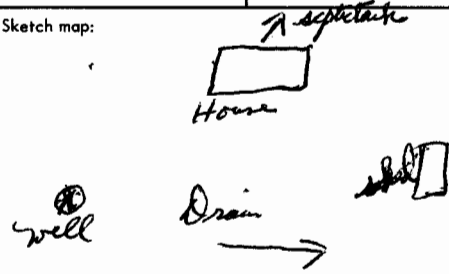
WATER WELL RECORD
KSA 82a-1201-1215

Kansas Department of Health and Environment-Division of Environment
(Water well Contractors)
Topeka, Kansas 66620

could be A 10A

B B A

Logan

1. Location of well:	County <i>Meade</i>	Traction <i>NWNWNE</i> <i>NE 1/4 NW 1/4 NW 1/4</i>	Section number <i>15</i>	Township number T <i>32</i> S R	Range number E/W <i>27</i>
2. Distance and direction from nearest town or city: <i>5 E 1 1/2 E</i>		3. Owner of well: <i>B & Rimer</i>			
Street address of well location if in city: <i>of Meade</i>		R.R. or street: City, state, zip code: <i>Meade Kans 67869</i>			
4. Locate with "X" in section below: 		Sketch map: 		6. Bore hole dia. <i>2 1/2</i> in. Completion date <i>10-15-75</i> Well depth <i>215</i> ft.	
5. Type and color of material		From		To	
<i>Sand Clay</i>		<i>0</i>		<i>25</i>	
<i>gray "</i>		<i>25</i>		<i>45</i>	
<i>light "</i>		<i>45</i>		<i>58</i>	
<i>Brown "</i>		<i>58</i>		<i>75</i>	
<i>Med. Sand</i>		<i>75</i>		<i>80</i>	
<i>Brown Clay</i>		<i>80</i>		<i>105</i>	
<i>" "</i>		<i>105</i>		<i>110</i>	
<i>Sand & gravel</i>		<i>110</i>		<i>130</i>	
<i>Sand Rock</i>		<i>130</i>		<i>138</i>	
<i>Clay</i>		<i>138</i>		<i>145</i>	
<i>Sandy Clay</i>		<i>145</i>		<i>178</i>	
<i>sand & gravel</i>		<i>178</i>		<i>190</i>	
<i>Clay</i>		<i>190</i>		<i>198</i>	
<i>gravel & Clay</i>		<i>198</i>		<i>205</i>	
<i>sand & gravel</i>		<i>205</i>		<i>215</i>	
<i>Red schale</i> (Use a second sheet if needed)		<i>215</i>			
18. Elevation: <i>2526</i> <i>ft</i>	19. Remarks: <i>17 Sears Pump</i> <i>Model + Number unknown to us</i>		20. Water well contractor's certification: This well was drilled under my jurisdiction and this report is true to the best of my knowledge and belief. <i>Bartel Dig 101 A</i> Business name License No. Address <i>Meade Kans</i> Signed <i>Peter Bartel</i> Date <i>10-30-75</i> Authorized representative		

Forward the white, blue and pink copies to the Department of Health and Environment

Form WWC-5

32 27W 15
 Sec
 NW 1/4
 NE 1/4
 SE 1/4
 SW 1/4