


1 LOCATION OF WATER WELL: Fraction SE 1/4 SE 1/4 NE 1/4 Section Number 17 Township Number T 32 S Range Number R 27 EW  
 County: MEADE

Distance and direction from nearest town or city street address of well if located within city?  
 3 East and 1 1/2 South of Meade, Kansas

2 WATER WELL OWNER: Mr. Eldo Wiens  
 RR#, St. Address, Box #: RFD Board of Agriculture, Division of Water Resources  
 City, State, ZIP Code: Meade, Kansas 67864 Application Number: ---

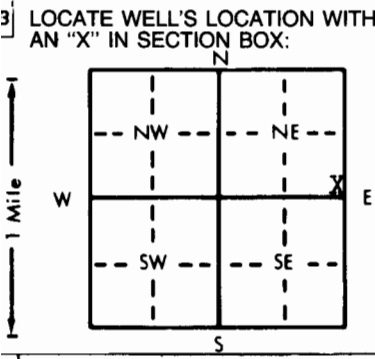

4 DEPTH OF COMPLETED WELL: 240 ft. ELEVATION: Slope  
 Depth(s) Groundwater Encountered 1. Not available ft. 2. ft. 3. ft.  
 WELL'S STATIC WATER LEVEL: 121 ft. below land surface measured on mo/day/yr May 29, 1986  
 Pump test data: Well water was ft. after hours pumping gpm  
 Est. Yield 30 gpm: Well water was ft. after hours pumping gpm  
 Bore Hole Diameter: 9 7/8 in. to 240 ft., and in. to ft.  
 WELL WATER TO BE USED AS:  
 Domestic 3 Feedlot 6 Oil field water supply 9 Dewatering 12 Other (Specify below)  
 Irrigation 4 Industrial 7 Lawn and garden only 10 Observation well  
 Was a chemical/bacteriological sample submitted to Department? Yes No ; If yes, mo/day/yr sample was submitted  
 Water Well Disinfected? Yes  No

5 TYPE OF BLANK CASING USED:  
 1 Steel 3 RMP (SR) 5 Wrought iron 8 Concrete tile CASING JOINTS: Glued  Clamped  
 PVC 4 ABS 7 Fiberglass Welded  
 Blank casing diameter 5 in. to 200 ft., Dia. in. to ft., Dia. in. to ft.  
 Casing height above land surface 15 in., weight 2.8 lbs./ft. Wall thickness or gauge No. 265  
 TYPE OF SCREEN OR PERFORATION MATERIAL:  PVC 10 Asbestos-cement  
 1 Steel 3 Stainless steel 5 Fiberglass 8 RMP (SR) 11 Other (specify)  
 2 Brass 4 Galvanized steel 6 Concrete tile 9 ABS 12 None used (open hole)  
 SCREEN OR PERFORATION OPENINGS ARE:  
 1 Continuous slot 3 Mill slot 5 Gauzed wrapped  Saw cut 11 None (open hole)  
 2 Louvered shutter 4 Key punched 6 Wire wrapped 9 Drilled holes  
 7 Torch cut 10 Other (specify)  
 SCREEN-PERFORATED INTERVALS: From 200 ft. to 240 ft., From ft. to ft.  
 GRAVEL PACK INTERVALS: From 14 ft. to 240 ft., From ft. to ft.

6 GROUT MATERIAL:  Neat cement 2 Cement grout 3 Bentonite 4 Other  
 Grout Intervals: From 4 ft. to 14 ft., From ft. to ft., From ft. to ft.  
 What is the nearest source of possible contamination:  
 Septic tank 4 Lateral lines 7 Pit privy 10 Livestock pens 14 Abandoned water well  
 2 Sewer lines 5 Cess pool 8 Sewage lagoon 11 Fuel storage 15 Oil well/Gas well  
 3 Watertight sewer lines 6 Seepage pit 9 Feedyard 12 Fertilizer storage 16 Other (specify below)  
 13 Insecticide storage  
 Direction from well? East How many feet? 100

FROM	TO	LITHOLOGIC LOG	FROM	TO	LITHOLOGIC LOG
0	2	Topsoil			
2	21	Clay			
21	37	Blue Clay			
37	71	Clay			
71	84	Red Clay			
84	206	Clay and Fine Sand			
206	237	Med. to Lar. Sand and Gravel			
237	240	Red Bed			

7 CONTRACTOR'S OR LANDOWNER'S CERTIFICATION: This water well was (1) constructed, (2) reconstructed, or (3) plugged under my jurisdiction and was completed on (mo/day/year) May 30, 1986 and this record is true to the best of my knowledge and belief. Kansas Water Well Contractor's License No. 252 This Water Well Record was completed on (mo/day/year) June 16, 1986 under the business name of FRIESEN WINDMILL & SUPPLY INC. by (signature)

INSTRUCTIONS: Use typewriter or ball point pen, PLEASE PRESS FIRMLY and PRINT clearly. Please fill in blanks, underline or circle the correct answers. Send top three copies to Kansas Department of Health and Environment, Division of Environment, Environmental Geology Section, Topeka, KS 66620. Send one to WATER WELL OWNER and retain one for your records.