


1 LOCATION OF WATER WELL: County: Meade Fraction: 10W 1/4 NE 1/4 SW 1/4 Section Number: 32 Township Number: T 32 S Range Number: R 27 E

Distance and direction from nearest town or city street address of well if located within city?  
4 S and 2 1/2 E of Meade

2 WATER WELL OWNER: Randel Classen  
 RR#, St. Address, Box #: \_\_\_\_\_ Board of Agriculture, Division of Water Resources  
 City, State, ZIP Code: Meade, KS 67864 Application Number: \_\_\_\_\_

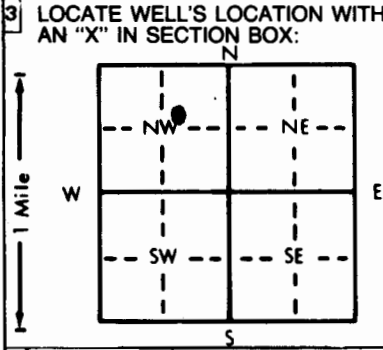

4 DEPTH OF COMPLETED WELL: 224 ft. ELEVATION: \_\_\_\_\_  
 Depth(s) Groundwater Encountered 1. \_\_\_\_\_ ft. 2. \_\_\_\_\_ ft. 3. \_\_\_\_\_ ft.  
 WELL'S STATIC WATER LEVEL \_\_\_\_\_ ft. below land surface measured on mo/day/yr 1-26-92  
 Pump test data: Well water was \_\_\_\_\_ ft. after 1 1/2 hours pumping 30 gpm  
 Est. Yield 30 gpm. Well water was \_\_\_\_\_ ft. after \_\_\_\_\_ hours pumping \_\_\_\_\_ gpm  
 Bore Hole Diameter: 8 3/4 in. to 224 ft., and \_\_\_\_\_ in. to \_\_\_\_\_ ft.  
 WELL WATER TO BE USED AS:  
 Domestic    3 Feedlot    6 Oil field water supply    9 Dewatering    12 Other (Specify below)  
 Irrigation    4 Industrial    7 Lawn and garden only    10 Monitoring well  
 Was a chemical/bacteriological sample submitted to Department? Yes \_\_\_\_\_ No ; If yes, mo/day/yr sample was submitted \_\_\_\_\_  
 Water Well Disinfected? Yes  No \_\_\_\_\_

5 TYPE OF BLANK CASING USED:  
 1 Steel    3 RMP (SR)    5 Wrought iron    8 Concrete tile    CASING JOINTS: Glued  Clamped \_\_\_\_\_  
 PVC    4 ABS    6 Asbestos-Cement    9 Other (specify below)    Welded \_\_\_\_\_  
 7 Fiberglass    Threaded \_\_\_\_\_  
 Blank casing diameter 5 in. to 184 ft. Dia \_\_\_\_\_ in. to \_\_\_\_\_ ft. Dia \_\_\_\_\_ in. to \_\_\_\_\_ ft.  
 Casing height above land surface 18 in., weight \_\_\_\_\_ lbs./ft. Wall thickness or gauge No. 200 PSI  
 TYPE OF SCREEN OR PERFORATION MATERIAL:  
 PVC    10 Asbestos-cement  
 1 Steel    3 Stainless steel    5 Fiberglass    8 RMP (SR)    11 Other (specify) \_\_\_\_\_  
 2 Brass    4 Galvanized steel    6 Concrete tile    9 ABS    12 None used (open hole)  
 SCREEN OR PERFORATION OPENINGS ARE:  
 1 Continuous slot    3 Mill slot    5 Gauzed wrapped     Saw cut    11 None (open hole)  
 2 Louvered shutter    4 Key punched    6 Wire wrapped    9 Drilled holes  
 7 Torch cut    10 Other (specify) \_\_\_\_\_  
 SCREEN-PERFORATED INTERVALS: From 184 ft. to 224 ft., From \_\_\_\_\_ ft. to \_\_\_\_\_ ft.  
 From \_\_\_\_\_ ft. to \_\_\_\_\_ ft., From \_\_\_\_\_ ft. to \_\_\_\_\_ ft.  
 GRAVEL PACK INTERVALS: From 20 ft. to 224 ft., From \_\_\_\_\_ ft. to \_\_\_\_\_ ft.  
 From \_\_\_\_\_ ft. to \_\_\_\_\_ ft., From \_\_\_\_\_ ft. to \_\_\_\_\_ ft.

6 GROUT MATERIAL: 1 Neat cement     Cement grout    3 Bentonite    4 Other \_\_\_\_\_  
 Grout Intervals: From 5 ft. to 20 ft., From \_\_\_\_\_ ft. to \_\_\_\_\_ ft., From \_\_\_\_\_ ft. to \_\_\_\_\_ ft.  
 What is the nearest source of possible contamination:  
 Livestock pens    14 Abandoned water well  
 1 Septic tank    4 Lateral lines    7 Pit privy    11 Fuel storage    15 Oil well/Gas well  
 2 Sewer lines    5 Cess pool    8 Sewage lagoon    12 Fertilizer storage    16 Other (specify below)  
 3 Watertight sewer lines    6 Seepage pit    9 Feedyard    13 Insecticide storage  
 Direction from well? S How many feet? 80

FROM	TO	LITHOLOGIC LOG	FROM	TO	PLUGGING INTERVALS
0	5	top soil			
5	30	brown clay			
30	55	white clay			
55	95	sandy clay			
95	110	gravel			
110	115	gravel + clay			
150	170	sand + gravel			
170	220	fine sand + clay			
220	224	gravel			

7 CONTRACTOR'S OR LANDOWNER'S CERTIFICATION: This water well was  constructed, (2) reconstructed, or (3) plugged under my jurisdiction and was completed on (mo/day/year) 1-27-92 and this record is true to the best of my knowledge and belief. Kansas Water Well Contractor's License No. 101 This Water Well Record was completed on (mo/day/yr) 8-4-92 under the business name of Bartel Well Drilling by (signature) Reuben J. Bartel