


1 LOCATION OF WATER WELL: County: Meade Fraction: SE 1/4 NE 1/4 SW 1/4 Section Number: 34 Township Number: T 32 S Range Number: R 27 E

Distance and direction from nearest town or city street address of well if located within city?
9 miles SE of Meade, Kansas 5 miles South

2 WATER WELL OWNER: Pete Doerksen
 RR#, St. Address, Box #: RR. Board of Agriculture, Division of Water Resources
 City, State, ZIP Code: meade, Kansas 67864 Application Number:

3 LOCATE WELL'S LOCATION WITH AN "X" IN SECTION BOX:

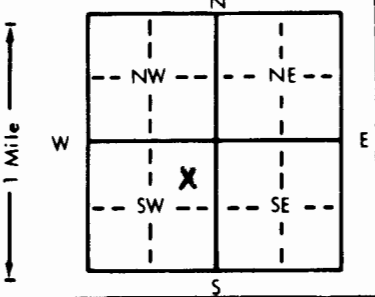

4 DEPTH OF COMPLETED WELL: 156 ft. ELEVATION:
 Depth(s) Groundwater Encountered 1: 115 ft. 2: ft. 3: ft.
 WELL'S STATIC WATER LEVEL: 56' ft. below land surface measured on 8/11/86
 Pump test data: Well water was 56 ft. after 1 1/2 hours pumping 30 gpm
 Est. Yield: 50 gpm; Well water was ft. after hours pumping gpm
 Bore Hole Diameter: 8 3/8 in. to 156 ft., and in. to ft.
 WELL WATER TO BE USED AS:
 Domestic 3 Feedlot 6 Oil field water supply 9 Dewatering 12 Other (Specify below)
 2 Irrigation 4 Industrial 7 Lawn and garden only 10 Observation well
 Was a chemical/bacteriological sample submitted to Department? Yes.....No ; If yes, mo/day/yr sample was submitted
 Water Well Disinfected? Yes No

5 TYPE OF BLANK CASING USED:
 Steel 3 RMP (SR) 5 Wrought iron 8 Concrete tile CASING JOINTS: Glued Clamped
 PVC 4 ABS 7 Fiberglass Welded
 Blank casing diameter: 5" in. to 116 ft., Dia in. to ft., Dia in. to ft.
 Casing height above land surface: 24 in., weight lbs./ft. Wall thickness or gauge No. 20016

TYPE OF SCREEN OR PERFORATION MATERIAL:
 Steel 3 Stainless steel 5 Fiberglass 8 RMP (SR) 10 Asbestos-cement
 2 Brass 4 Galvanized steel 6 Concrete tile 9 ABS 12 None used (open hole)
 SCREEN OR PERFORATION OPENINGS ARE:
 1 Continuous slot 3 Mill slot 5 Gauzed wrapped Saw cut 11 None (open hole)
 2 Louvered shutter 4 Key punched 6 Wire wrapped 9 Drilled holes
 7 Torch cut 10 Other (specify)

SCREEN-PERFORATED INTERVALS: From 116 ft. to 156 ft., From ft. to ft.
 GRAVEL PACK INTERVALS: From 15 ft. to 156 ft., From ft. to ft.

6 GROUT MATERIAL: 1 Neat cement Cement grout 3 Bentonite 4 Other
 Grout Intervals: From top ft. to 15 ft., From ft. to ft., From ft. to ft.

What is the nearest source of possible contamination:
 1 Septic tank 4 Lateral lines 7 Pit privy 10 Livestock pens 14 Abandoned water well
 2 Sewer lines 5 Cess pool 8 Sewage lagoon 11 Fuel storage 15 Oil well/Gas well
 3 Watertight sewer lines 6 Seepage pit 9 Feedyard 12 Fertilizer storage 16 Other (specify below)
 13 Insecticide storage Creek
 Direction from well? East How many feet? 30

FROM	TO	LITHOLOGIC LOG	FROM	TO	LITHOLOGIC LOG
0	5	Top Soil			
5	15	Sand			
15	40	Sand Stone			
40	115	White Clay			
115	125	Gravel			
125	135	Clay & Sand			
135	156	Gravel			

7 CONTRACTOR'S OR LANDOWNER'S CERTIFICATION: This water well was constructed, (2) reconstructed, or (3) plugged under my jurisdiction and was completed on (mo/day/year) 8/11/86 and this record is true to the best of my knowledge and belief. Kansas Water Well Contractor's License No. 1016 This Water Well Record was completed on (mo/day/yr) 8/21/86 under the business name of Bartel Well Drilling by (signature) Reuben Bartel

INSTRUCTIONS: Use typewriter or ball point pen, PLEASE PRESS FIRMLY and PRINT clearly. Please fill in blanks, underline or circle the correct answers. Send top three copies to Kansas Department of Health and Environment, Division of Environment, Environmental Geology Section, Topeka, KS 66620. Send one to WATER WELL OWNER and retain one for your records.

OFFICE USE ONLY
T
R
EW
SEC.