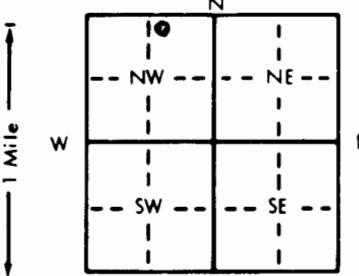


1 LOCATION OF WATER WELL: Fraction NW 1/4 NE 1/4 NW 1/4 Section Number 11 Township Number T 32 S Range Number R 28 EW
 County: Meade

Distance and direction from nearest town or city street address of well if located within city?
623 East Carthage, Meade, KS.

2 WATER WELL OWNER: City of Meade
 RR#, St. Address, Box #: Municipal Plant 623 E. Carthage Board of Agriculture, Division of Water Resources
 City, State, ZIP Code: Meade, Ks. 67864 Application Number:

3 LOCATE WELL'S LOCATION WITH AN "X" IN SECTION BOX:

 4 DEPTH OF COMPLETED WELL: 20' ft. ELEVATION:
 Depth(s) Groundwater Encountered 1. 15' ft. 2. _____ ft. 3. _____ ft.
 WELL'S STATIC WATER LEVEL 12.93 ft. below land surface measured on mo/day/yr 9-23-96
 Pump test data: Well water was _____ ft. after _____ hours pumping _____ gpm
 Est. Yield _____ gpm Well water was _____ ft. after _____ hours pumping _____ gpm
 Bore Hole Diameter: 8 1/2" in. to 20' ft. and _____ in. to _____ ft.
 WELL WATER TO BE USED AS:
 5 Public water supply 8 Air conditioning 11 Injection well
 1 Domestic 3 Feedlot 6 Oil field water supply 9 Dewatering
 2 Irrigation 4 Industrial 7 Lawn and garden only 10 Monitoring well Vapor Ext.
 Was a chemical/bacteriological sample submitted to Department? Yes _____ No X; If yes, mo/day/yr sample was submitted
 Water Well Disinfected? Yes _____ No (No)

5 TYPE OF BLANK CASING USED:
 1 Steel 3 RMP (SR) 5 Wrought iron 8 Concrete tile CASING JOINTS: Glued _____ Clamped _____
2 PVC 4 ABS 6 Asbestos-Cement 9 Other (specify below) Welded _____
 7 Fiberglass Threaded X
 Blank casing diameter 2.375 in. to 10' ft. Dia _____ in. to _____ ft. Dia _____ in. to SDR 13 ft.
 Casing height above land surface Flush Mt. in., weight _____ lbs./ft. Wall thickness or gauge No. SCH 40
 TYPE OF SCREEN OR PERFORATION MATERIAL:
 1 Steel 3 Stainless steel 5 Fiberglass 8 RMP (SR) 10 Asbestos-cement
 2 Brass 4 Galvanized steel 6 Concrete tile 9 ABS 11 Other (specify) _____
 12 None used (open hole)
 SCREEN OR PERFORATION OPENINGS ARE:
 1 Continuous slot 3 Mill slot 5 Gauzed wrapped 8 Saw cut 11 None (open hole)
 2 Louvered shutter 4 Key punched 6 Wire wrapped 9 Drilled holes
 7 Torch cut 10 Other (specify) _____
 SCREEN-PERFORATED INTERVALS: From 20' ft. to 10' ft. From _____ ft. to _____ ft.
 From _____ ft. to _____ ft. From _____ ft. to _____ ft.
 GRAVEL PACK INTERVALS: From 20' ft. to 9' ft. From _____ ft. to _____ ft.
 From _____ ft. to _____ ft. From _____ ft. to _____ ft.

6 GROUT MATERIAL: 1 Neat cement 2 Cement grout 3 Bentonite 4 Other _____
 Grout Intervals: From 9' ft. to 4' ft. From 4' ft. to 0' ft. From _____ ft. to _____ ft.
 What is the nearest source of possible contamination:
 1 Septic tank 4 Lateral lines 7 Pit privy 10 Livestock pens 14 Abandoned water well
 2 Sewer lines 5 Cess pool 8 Sewage lagoon 11 Fuel storage 15 Oil well/Gas well
 3 Watertight sewer lines 6 Seepage pit 9 Feedyard 12 Fertilizer storage 16 Other (specify below) _____
 13 Insecticide storage
 Direction from well? West How many feet? 70'

FROM	TO	LITHOLOGIC LOG	FROM	TO	PLUGGING INTERVALS
0	.50	Gravel			
.50	7	Dk gray brn silty clay, dry, faint odor, firm, low plasticity.			
7	12	Tan gray silty clay w/ dk gray clay stringers, faint odor, dry to moist.			
12	18.25	Gray silty clay w/ tan silty clay banding, moist to wet at 15', mod. odor, soft.			
18.25	20	Green gray silty clay, wet, strong odor, highly plastic.			
Flush Mt. OK'D by Don Taylor					

7 CONTRACTOR'S OR LANDOWNER'S CERTIFICATION: This water well was (1) constructed, (2) reconstructed, or (3) plugged under my jurisdiction and was completed on (mo/day/year) 9-18-96 and this record is true to the best of my knowledge and belief. Kansas Water Well Contractor's License No. 539 This Water Well Record was completed on (mo/day/yr) 10-25-96 under the business name of JB Environmental Drilling by (signature) James Baker

OFFICE USE ONLY