


1 LOCATION OF WATER WELL: County: Meade Fraction: NW 1/4 NE 1/4 NW 1/4 Section Number: 11 Township Number: T 32 S Range Number: R 28 EW

Distance and direction from nearest town or city street address of well if located within city?
623 East Carthage, Meade, KS.

2 WATER WELL OWNER: City of Meade
 RR#, St. Address, Box #: Municipal Plant 623 E. Carthage
 City, State, ZIP Code: Meade, Ks. 67864
 Board of Agriculture, Division of Water Resources
 Application Number:

3 LOCATE WELL'S LOCATION WITH AN "X" IN SECTION BOX:

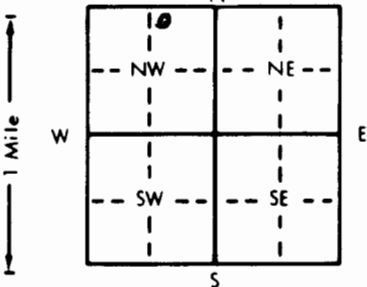

4 DEPTH OF COMPLETED WELL: 20' ft. ELEVATION: _____ ft.
 Depth(s) Groundwater Encountered: 1. 16' ft. 2. _____ ft. 3. _____ ft.
 WELL'S STATIC WATER LEVEL: 16.35 ft. below land surface measured on mo/day/yr 9-23-96
 Pump test data: Well water was _____ ft. after _____ hours pumping _____ gpm
 Est. Yield _____ gpm Well water was _____ ft. after _____ hours pumping _____ gpm
 Bore Hole Diameter: 8 1/2' in. to 20' in. and _____ in. to _____ in. ft.
 WELL WATER TO BE USED AS:
 5 Public water supply 8 Air conditioning 11 Injection well
 1 Domestic 3 Feedlot 6 Oil field water supply 9 Dewatering
 2 Irrigation 4 Industrial 7 Lawn and garden only 10 Monitoring well
 Was a chemical/bacteriological sample submitted to Department? Yes _____ No X; If yes, mo/day/yr sample was submitted _____
 Water Well Disinfected? Yes _____ No (No)

5 TYPE OF BLANK CASING USED:
 1 Steel 3 RMP (SR) 5 Wrought iron 8 Concrete tile CASING JOINTS: Glued _____ Clamped _____
2 PVC 4 ABS 6 Asbestos-Cement 9 Other (specify below) Welded _____
 7 Fiberglass Threaded X
 Blank casing diameter 2.375 in. to 10' ft. Dia _____ in. to _____ ft. Dia _____ in. to SDR 13 ft.
 Casing height above land surface Flush Mt. in., weight _____ lbs./ft. Wall thickness or gauge No. SCH 40

TYPE OF SCREEN OR PERFORATION MATERIAL:
 1 Steel 3 Stainless steel 5 Fiberglass 8 RMP (SR) 10 Asbestos-cement
 2 Brass 4 Galvanized steel 6 Concrete tile 9 ABS 11 Other (specify) _____
 12 None used (open hole)

SCREEN OR PERFORATION OPENINGS ARE:
 1 Continuous slot 3 Mill slot 5 Gauzed wrapped 8 Saw cut 11 None (open hole)
 2 Louvered shutter 4 Key punched 6 Wire wrapped 9 Drilled holes
 7 Torch cut 10 Other (specify) _____

SCREEN-PERFORATED INTERVALS: From 20' ft. to 10' ft. From _____ ft. to _____ ft.
 From _____ ft. to _____ ft. From _____ ft. to _____ ft.
 GRAVEL PACK INTERVALS: From 20' ft. to 9' ft. From _____ ft. to _____ ft.
 From _____ ft. to _____ ft. From _____ ft. to _____ ft.

6 GROUT MATERIAL: 1 Neat cement 2 Cement grout 3 Bentonite 4 Other
 Grout Intervals: From 9' ft. to 4' ft. From 4' ft. to 0' ft. From _____ ft. to _____ ft.
 What is the nearest source of possible contamination:
 1 Septic tank 4 Lateral lines 7 Pit privy 10 Livestock pens 14 Abandoned water well
 2 Sewer lines 5 Cess pool 8 Sewage lagoon 11 Fuel storage 15 Oil well/Gas well
 3 Watertight sewer lines 6 Seepage pit 9 Feedyard 12 Fertilizer storage 16 Other (specify below)
 13 Insecticide storage
 Direction from well: Southeast How many feet? 60'

FROM	TO	LITHOLOGIC LOG	FROM	TO	PLUGGING INTERVALS
0	.50	Gravel			
.50	6	DR brn clay, hard, dry, no odor			
6	9	Tan clayey silt, dry, no odor, no plasticity, caliche nodules & stringers.			
9	16	White w/ gray tint caliche sand, fine grained qtz sand w/ silt, dry, faint to slight odor.			
16	20	Gray-white gray mottled silty sand, w/ caliche, wet, mod.odor, soft.			

7 CONTRACTOR'S OR LANDOWNER'S CERTIFICATION: This water well was (1) constructed, (2) reconstructed, or (3) plugged under my jurisdiction and was completed on (mo/day/year) 9-20-96 and this record is true to the best of my knowledge and belief. Kansas Water Well Contractor's License No. 539 This Water Well Record was completed on (mo/day/yr) 10-25-96 under the business name of JB Environmental Drilling by signature James Baker

OFFICE USE ONLY
T
R
EW
SEC.
1/4
1/4
1/4