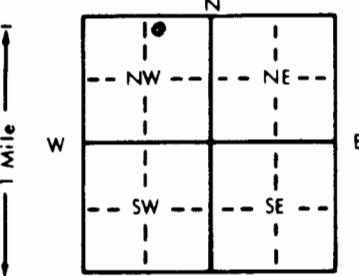


1 LOCATION OF WATER WELL: Fraction NW 1/4 NE 1/4 NW 1/4 Section Number 11 Township Number T 32 S Range Number R 28 EW  
 County: Meade

Distance and direction from nearest town or city street address of well if located within city?  
623 East Carthage, Meade, KS.

2 WATER WELL OWNER: City of Meade  
 RR#, St. Address, Box #: Municipal Plant 623 E. Carthage Board of Agriculture, Division of Water Resources  
 City, State, ZIP Code: Meade, Ks. 67864 Application Number:

3 LOCATE WELL'S LOCATION WITH AN "X" IN SECTION BOX:  


4 DEPTH OF COMPLETED WELL: 27' ft. ELEVATION:  
 Depth(s) Groundwater Encountered 1. 14' ft. 2. ft. 3. ft.  
 WELL'S STATIC WATER LEVEL 11.20 ft. below land surface measured on mo/day/yr 9-21-96  
 Pump test data: Well water was ft. after hours pumping gpm  
 Est. Yield gpm: Well water was ft. after hours pumping gpm  
 Bore Hole Diameter: 8 1/2" in. to 27' ft. and in. to ft.  
 WELL WATER TO BE USED AS: 5 Public water supply 8 Air conditioning 11 Injection well  
 1 Domestic 3 Feedlot 6 Oil field water supply 9 Dewatering 12 Other (Specify below)  
 2 Irrigation 4 Industrial 7 Lawn and garden only 10 Monitoring well Artificial Recovery  
 Was a chemical/bacteriological sample submitted to Department? Yes No X; If yes, mo/day/yr sample was submitted  
 Water Well Disinfected? Yes No

5 TYPE OF BLANK CASING USED: 5 Wrought iron 8 Concrete tile CASING JOINTS: Glued Clamped  
 1 Steel 3 RMP (SR) 6 Asbestos-Cement 9 Other (specify below) Welded  
2 PVC 4 ABS 7 Fiberglass Threaded X  
 Blank casing diameter 2.375 in. to 12' ft. Dia. in. to ft. Dia. in. to SDR 13 ft.  
 Casing height above land surface Flush Mt. in., weight lbs./ft. Wall thickness or gauge No. SCH. 40  
 TYPE OF SCREEN OR PERFORATION MATERIAL: 7 PVC 10 Asbestos-cement  
 1 Steel 3 Stainless steel 5 Fiberglass 8 RMP (SR) 11 Other (specify)  
 2 Brass 4 Galvanized steel 6 Concrete tile 9 ABS 12 None used (open hole)  
 SCREEN OR PERFORATION OPENINGS ARE: 5 Gauzed wrapped 8 Saw cut 11 None (open hole)  
 1 Continuous slot 3 Mill slot 6 Wire wrapped 9 Drilled holes  
 2 Louvered shutter 4 Key punched 7 Torch cut 10 Other (specify)  
 SCREEN-PERFORATED INTERVALS: From 27' ft. to 12' ft. From ft. to ft.  
 From ft. to ft. From ft. to ft.  
 GRAVEL PACK INTERVALS: From 27' ft. to 10' ft. From ft. to ft.  
 From ft. to ft. From ft. to ft.

6 GROUT MATERIAL: 1 Neat cement 2 Cement grout 3 Bentonite 4 Other  
 Grout Intervals: From 10' ft. to 4' ft. From 4' ft. to 0' ft. From ft. to ft.  
 What is the nearest source of possible contamination:  
 1 Septic tank 4 Lateral lines 7 Pit privy 10 Livestock pens 14 Abandoned water well  
 2 Sewer lines 5 Cess pool 8 Sewage lagoon 11 Fuel storage 15 Oil well/Gas well  
 3 Watertight sewer lines 6 Seepage pit 9 Feedyard 12 Fertilizer storage 16 Other (specify below)  
 13 Insecticide storage  
 Direction from well? West North West How many feet? 80'

FROM	TO	LITHOLOGIC LOG	FROM	TO	PLUGGING INTERVALS
0	.50	Gravel-broken asphalt.			
.50	5	Dk brn clay, dry, tight, no odor, low-no plasticity.			
5	7	Med brn clay w/ oxides staining, dry-moist, no odor.			
7	13	Tan brn silty clay, moist, semi fraible, no odor.			
13	16.50	Gray brn silty clay w/ dk gray banding, mod. to strong odor, moist to wet, soft.			
16.50	27	Gray silty sand to sandy silt, wet, strong odor, fine grained sand.			

*F.M. OK'd by Don Taylor*

7 CONTRACTOR'S OR LANDOWNER'S CERTIFICATION: This water well was (1) constructed (2) reconstructed, or (3) plugged under my jurisdiction and was completed on (mo/day/year) 9-21-96 and this record is true to the best of my knowledge and belief. Kansas Water Well Contractor's License No. 539 This Water Well Record was completed on (mo/day/yr) 10-25-96 under the business name of JB Environmental Drilling by signature James Baker

OFFICE USE ONLY  
T  
R  
EW  
SEC.  
1/4  
1/4  
1/4