


1 LOCATION OF WATER WELL: Fraction NW 1/4 DE 1/4 NW 1/4 Section Number 11 Township Number T 32 S Range Number R 28 E/W  
 County: Meade

Distance and direction from nearest town or city street address of well if located within city?  
623 East Carthage St. Meade, KS.

2 WATER WELL OWNER: City of Meade/Municipal Plant  
 RR#, St. Address, Box #: 623 E. Carthage Board of Agriculture, Division of Water Resources  
 City, State, ZIP Code: Meade, KS. 67864 Application Number:

3 LOCATE WELL'S LOCATION WITH AN "X" IN SECTION BOX:

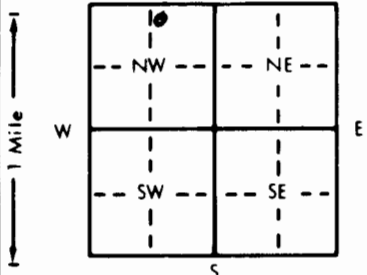

4 DEPTH OF COMPLETED WELL: 27' ft. ELEVATION:

Depth(s) Groundwater Encountered 1. 10' ft. 2. ft. 3. ft.  
 WELL'S STATIC WATER LEVEL 9.84 ft. below land surface measured on mo/day/yr 9-24-96  
 Pump test data: Well water was ft. after hours pumping gpm  
 Est. Yield gpm: Well water was ft. after hours pumping gpm  
 Bore Hole Diameter: 8 1/2" in. to 27' ft., and in. to ft.  
 WELL WATER TO BE USED AS:  
 1 Domestic 3 Feedlot 6 Oil field water supply 9 Dewatering 12 Other (Specify below)  
 2 Irrigation 4 Industrial 7 Lawn and garden only 10 Monitoring well Product Recovery  
 Was a chemical/bacteriological sample submitted to Department? Yes No. X If yes, mo/day/yr sample was submitted

5 TYPE OF BLANK CASING USED:  
 1 Steel 3 RMP (SR) 5 Wrought iron 8 Concrete tile CASING JOINTS: Glued Clamped  
 2 PVC 4 ABS 6 Asbestos-Cement 9 Other (specify below) Welded  
 7 Fiberglass Threaded: X

Blank casing diameter 2.375 in. to 12' ft., Dia. in. to ft., Dia. in. to SDR 13 ft.  
 Casing height above land surface Flush Mt. in., weight lbs./ft. Wall thickness or gauge No. SCH 40

TYPE OF SCREEN OR PERFORATION MATERIAL:  
 1 Steel 3 Stainless steel 5 Fiberglass 8 RMP (SR) 10 Asbestos-cement  
 2 Brass 4 Galvanized steel 6 Concrete tile 9 ABS 11 Other (specify)  
 12 None used (open hole)

SCREEN OR PERFORATION OPENINGS ARE:  
 1 Continuous slot 3 Mill slot 5 Gauzed wrapped 8 Saw cut 11 None (open hole)  
 2 Louvered shutter 4 Key punched 6 Wire wrapped 9 Drilled holes  
 7 Torch cut 10 Other (specify)

SCREEN-PERFORATED INTERVALS: From 27' ft. to 12' ft., From ft. to ft.  
 From ft. to ft., From ft. to ft.  
 GRAVEL PACK INTERVALS: From 27' ft. to 10' ft., From ft. to ft.  
 From ft. to ft., From ft. to ft.

6 GROUT MATERIAL: 1 Neat cement 2 Cement grout 3 Bentonite 4 Other  
 Grout Intervals: From 10' ft. to 4' ft., From 4' ft. to 0' ft., From ft. to ft.

What is the nearest source of possible contamination:  
 1 Septic tank 4 Lateral lines 7 Pit privy 10 Livestock pens 14 Abandoned water well  
 2 Sewer lines 5 Cess pool 8 Sewage lagoon 11 Fuel storage 15 Oil well/Gas well  
 3 Watertight sewer lines 6 Seepage pit 9 Feedyard 12 Fertilizer storage 16 Other (specify below)  
 13 Insecticide storage  
 Direction from well: South How many feet? 100'

| FROM  | TO    | LITHOLOGIC LOG  | FROM | TO | PLUGGING INTERVALS |
|-------|-------|---|------|----|--------------------|
| 0     | .50   | Concrete  |      |    |                    |
| .50   | 7.75  | Dk-med brn silty clayfill, loose, mottled, soft, no odor.                                 |      |    |                    |
| 7.75  | 11.25 | Med brn silty clay, moist-wet, soft, highly plastic, faint odor.                          |      |    |                    |
| 11.25 | 17    | Lt brn sandy clay, wet, no odor, fine grained sand, very soft, subrounded, poorly sorted. |      |    |                    |
| 17    | 23    | Gray silty clay, wet, odor, mottled, highly plastic.                                      |      |    |                    |
| 23    | 27    | Tan silty clay, stiff, no odor, wet, highly plastic.                                      |      |    |                    |

Flush mt. OK'd by Don Taylor:

7 CONTRACTOR'S OR LANDOWNER'S CERTIFICATION: This water well was (1) constructed, (2) reconstructed, or (3) plugged under my jurisdiction and was completed on (mo/day/year) 9-24-96 and this record is true to the best of my knowledge and belief. Kansas Water Well Contractor's License No. 539 This Water Well Record was completed on (mo/day/yr) 10-25-96 under the business name of JB Environmental Drilling by (signature) James Baker

OFFICE USE ONLY  
T  
R  
EM  
SEC.  
1/4  
1/4  
1/4