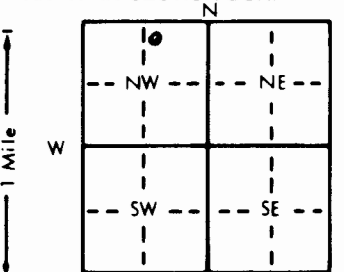


1 LOCATION OF WATER WELL:		Fraction NW 1/4 NE 1/4 SW 1/4		Section Number 11		Township Number T 32 S		Range Number R 28 EW	
County: Meade									
Distance and direction from nearest town or city street address of well if located within city? 623 East Carthage St., Meade, KS.									
2 WATER WELL OWNER: City of Meade									
RR#, St. Address, Box #: 623 E. Carthage									
City, State, ZIP Code: Meade, KS. 67864									
Board of Agriculture, Division of Water Resources									
Application Number:									
3 LOCATE WELL'S LOCATION WITH AN "X" IN SECTION BOX:		4 DEPTH OF COMPLETED WELL 13' ft. ELEVATION:							
		Depth(s) Groundwater Encountered 1. 13' ft. 2. ft. 3. ft.							
		WELL'S STATIC WATER LEVEL 10.22 ft. below land surface measured on mo/day/yr 9-24-96							
		Pump test data: Well water was ft. after hours pumping gpm							
		Est. Yield gpm: Well water was ft. after hours pumping gpm							
		Bore Hole Diameter 8 1/2" in. to 13' ft. and in. to ft.							
		WELL WATER TO BE USED AS: 5 Public water supply 8 Air conditioning 11 Injection well							
		1 Domestic 3 Feedlot 6 Oil field water supply 9 Dewatering 12 Other (Specify below)							
		2 Irrigation 4 Industrial 7 Lawn and garden only 10 Monitoring well Vapoc Extraction							
		Was a chemical/bacteriological sample submitted to Department? Yes No X If yes, mo/day/yr sample was submitted							
		Water Well Disinfected? Yes No							
5 TYPE OF BLANK CASING USED:									
1 Steel 3 RMP (SR) 5 Wrought iron 8 Concrete tile CASING JOINTS: Glued Clamped									
2 PVC 4 ABS 6 Asbestos-Cement 9 Other (specify below) Welded									
7 Fiberglass Threaded X									
Blank casing diameter 2.375 in. to 8 1/2" ft. Dia in. to ft. Dia in. to SDR 13 ft.									
Casing height above land surface Flush Mt. in. weight lbs./ft. Wall thickness or gauge No. SCH 40									
TYPE OF SCREEN OR PERFORATION MATERIAL:									
1 Steel 3 Stainless steel 5 Fiberglass 8 RMP (SR) 10 Asbestos-cement									
2 Brass 4 Galvanized steel 6 Concrete tile 9 ABS 11 Other (specify)									
12 None used (open hole)									
SCREEN OR PERFORATION OPENINGS ARE:									
1 Continuous slot 3 Mill slot 5 Gauzed wrapped 8 Saw cut 11 None (open hole)									
2 Louvered shutter 4 Key punched 6 Wire wrapped 9 Drilled holes									
10 Other (specify)									
SCREEN-PERFORATED INTERVALS: From 12 1/2' ft. to 8 1/2' ft. From ft. to ft.									
From ft. to ft. From ft. to ft.									
GRAVEL PACK INTERVALS: From 13' ft. to 7 1/2' ft. From ft. to ft.									
From ft. to ft. From ft. to ft.									
6 GROUT MATERIAL:									
1 Neat cement 2 Cement grout 3 Bentonite 4 Other									
Grout Intervals: From 7 1/2' ft. to 4' ft. From 4' ft. to 0' ft. From ft. to ft.									
What is the nearest source of possible contamination:									
1 Septic tank 4 Lateral lines 7 Pit privy 10 Livestock pens 14 Abandoned water well									
2 Sewer lines 5 Cess pool 8 Sewage lagoon 11 Fuel storage 15 Oil well/Gas well									
3 Watertight sewer lines 6 Seepage pit 9 Feedyard 12 Fertilizer storage 16 Other (specify below)									
13 Insecticide storage									
Direction from well? South How many feet? 120'									
FROM TO LITHOLOGIC LOG FROM TO PLUGGING INTERVALS									
0 .25 Asphalt									
.25 7.25 Dk brn to blk silty clay, friable, low plasticity, no odor, moist-damp.									
7.25 13 Gray sandy clay, moist, med. plasticity, faint odor, fine grained sand w/ few caliche nodules, w/ dk gray banding, strong odor, wet at 13'.									
Flush mt. OK'd by Don Taylor									
7 CONTRACTOR'S OR LANDOWNER'S CERTIFICATION: This water well was (1) constructed (2) reconstructed, or (3) plugged under my jurisdiction and was completed on (mo/day/year) 9-24-96 and this record is true to the best of my knowledge and belief. Kansas Water Well Contractor's License No. 539 This Water Well Record was completed on (mo/day/yr) 10-25-96 under the business name of JB Environmental Drilling by (signature) James Becker									
INSTRUCTIONS: Use typewriter or ball point pen. PLEASE PRESS FIRMLY and PRINT clearly. Please fill in blanks, underline or circle the correct answers. Send top three copies to Kansas Department of Health and Environment, Bureau of Water, Topeka, Kansas 66620-0001. Telephone: 913-296-5545. Send one to WATER WELL OWNER and retain one for your records.									