

1 LOCATION OF WATER WELL: Fraction NE  $\frac{1}{4}$  ~~SW~~  $\frac{1}{4}$  ~~SE~~  $\frac{1}{4}$  Section Number 22 Township Number T 32 S Range Number R 28 EM

Distance and direction from nearest town or city street address of well if located within city?


2 S and 1/2 W from Meade

2 WATER WELL OWNER: Tim Ross

RR#, St. Address, Box # :  
 City, State, ZIP Code : Meade, KS 67804

Board of Agriculture, Division of Water Resources  
 Application Number:

3 LOCATE WELL'S LOCATION WITH AN "X" IN SECTION BOX: 4 DEPTH OF COMPLETED WELL 246 ft. ELEVATION:

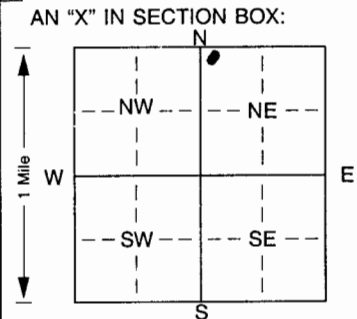

Depth(s) Groundwater Encountered 1. 49 ft. 2. 49 ft. 3. 49 ft.  
 WELL'S STATIC WATER LEVEL 49 ft. below land surface measured on mo/day/yr  
 Pump test data: Well water was 49 ft. after 1 hours pumping 30 gpm  
 Est. Yield 50 gpm; Well water was 49 ft. after 1 hours pumping 30 gpm  
 Bore Hole Diameter 8 3/4 in. to 246 ft., and 246 in. to 246 ft.  
 WELL WATER TO BE USED AS: 5 Public water supply 8 Air conditioning 11 Injection well  
 1 Domestic 3 Feedlot 6 Oil field water supply 9 Dewatering 12 Other (Specify below)  
 2 Irrigation 4 Industrial 7 Domestic (lawn & garden) 10 Monitoring well  
 Was a chemical/bacteriological sample submitted to Department? Yes.    No.  ; if yes, mo/day/yr sample was submitted  
 Water Well Disinfected? Yes  No   

5 TYPE OF BLANK CASING USED: 5 Wrought iron 8 Concrete tile CASING JOINTS: Glued  Clamped     
 1 Steel 3 RMP (SR) 6 Asbestos-Cement 9 Other (specify below) Welded     
PVC 4 ABS 7 Fiberglass Threaded   

Blank casing diameter 5 in. to 206 ft., Dia 5 in. to 206 ft., Dia 5 in. to 206 ft.  
 Casing height above land surface 18 in., weight    lbs./ft. Wall thickness or gauge No. 206

TYPE OF SCREEN OR PERFORATION MATERIAL: PVC 10 Asbestos-cement  
 1 Steel 3 Stainless steel 5 Fiberglass 8 RMP (SR) 11 Other (specify)     
 2 Brass 4 Galvanized steel 6 Concrete tile 9 ABS 12 None used (open hole)

SCREEN OR PERFORATION OPENINGS ARE: 5 Gauzed wrapped PVC 11 None (open hole)  
 1 Continuous slot 3 Mill slot 6 Wire wrapped 9 Drilled holes  
 2 Louvered shutter 4 Key punched 7 Torch cut 10 Other (specify)    ft.

SCREEN-PERFORATED INTERVALS: From 206 ft. to 246 ft., From    ft. to    ft.  
 From    ft. to    ft., From    ft. to    ft.  
 GRAVEL PACK INTERVALS: From 20 ft. to 246 ft., From    ft. to    ft.  
 From    ft. to    ft., From    ft. to    ft.

6 GROUT MATERIAL: 1 Neat cement 2 Cement grout Bentonite 4 Other   

Grout Intervals: From 4 ft. to 20 ft., From    ft. to    ft., From    ft. to    ft.  
 What is the nearest source of possible contamination:  
 Septic tank 4 Lateral lines 7 Pit privy 10 Livestock pens 14 Abandoned water well  
 2 Sewer lines 5 Cess pool 8 Sewage lagoon 11 Fuel storage 15 Oil well/Gas well  
 3 Watertight sewer lines 6 Seepage pit 9 Feedyard 12 Fertilizer storage 16 Other (specify below)  
 Direction from well? S How many feet? 150

FROM	TO	LITHOLOGIC LOG	FROM	TO	PLUGGING INTERVALS
<u>0</u>	<u>5</u>	<u>topsoil</u>			
<u>5</u>	<u>12</u>	<u>brown clay</u>			
<u>12</u>	<u>18</u>	<u>sand</u>			
<u>18</u>	<u>65</u>	<u>brown clay</u>			
<u>65</u>	<u>205</u>	<u>blue clay</u>			
<u>205</u>	<u>246</u>	<u>sand + gravel</u>			

7 CONTRACTOR'S OR LANDOWNER'S CERTIFICATION: This water well was  constructed, (2) reconstructed, or (3) plugged under my jurisdiction and was completed on (mo/day/year) 5-30-01 and this record is true to the best of my knowledge and belief. Kansas Water Well Contractor's Licence No. 101 This Water Well Record was completed on (mo/day/yr) 5-30-01 under the business name of Bartel Well Drilling, Inc by (signature) Rudolf J. Bartel