

1	LOCATION OF WATER WELL:	Fraction	Section Number	Township Number	Range Number
County:	MEADE	NW ¼ NE ¼ NE ¼	10	T 32 S	R 28

Distance and direction from nearest town or city street address of well if located within city?


2	WATER WELL OWNER: Meade Coop Elevator & Supply
---	--

RR#, St. Address, Box # : Randy Aikerman
City, State, ZIP Code : P.O. Box 220

Board of Agriculture, Division of Water Resources
Application Number:

3 LOCATE WELL'S LOCATION WITH 4 DEPTH OF COMPLETED WELL 55.0 ft. ELEVATION.

AN "X" IN SECTION BOX:

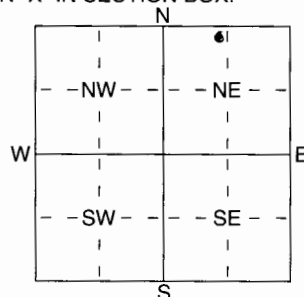

Depth(s) Groundwater Encountered 1 ft. 2 ft. 3 ft.
WELL'S STATIC WATER LEVEL ft. below land surface measured on mo/day/yr

Pump test data:	Well water was	ft. after	hours pumping	gpm	
Est. Yield	gpm:	Well water was	ft. after	hours pumping	gpm

WELL WATER TO BE USED AS:

1 Domestic	3 Feedlot	5 Public water supply	8 Air conditioning	11 Injection well
2 Irrigation	4 Industrial	6 Oil field water supply	9 Dewatering	12 Other (Specify below)
		7 Domestic (lawn & garden)	10 Monitoring well	

Was a chemical/bacteriological sample submitted to Department? Yes No; If yes, mo/day/hrs sample was submitted

5	TYPE OF BLANK CASING USED:
---	----------------------------

1 Steel	3 RMP (SR)
2 PVC	4 ABS

5 Wrought iron
6 Asbestos-Cement
7 Fiberglass

8 Concrete tile
9 Other (specify below)

CASING JOINTS: Glued Clamped
Welded
Threaded **X**

Blank casing diameter 2 in. to 55 ft. Dia _____ in. to _____ ft. Dia _____ in. to _____ ft.

Casing height above land surface in., weight lbs./ft. Wall thickness or gauge No. 5440 PVO

TYPE OF SCREEN OR PERFORATION MATERIAL:

1 Steel	3 Stainless Steel
2 Brass	4 Galvanized Steel

5 Fiberglass
6 Concrete tile

8 RMP (SR)
9 ABS

10 Asbestos-Cement
11 Other (Specify)
12 None used (open hole)

SCREEN OR PERFORATION OPENINGS ARE:

1 Continuous slot
2 Louvered shutter
3 Mill slot
4 Key punched

5 Guazed wrapped
6 Wire wrapped
7 Torch cut

8 Saw cut
9 Drilled holes
10 Other (specify) ft.
11 None (open hole)

SCREEN-PERFORATED INTERVALS: From 35 ft. to 55 ft. From _____ ft. to _____ ft.

GRAVEL PACK INTERVALS: From 33 ft. to 55 ft. From _____ ft. to _____ ft.

6	GROUT MATERIAL:	1 Neat cement	2 Cement grout	3 Bentonite	4 Other
---	-----------------	---------------	----------------	-------------	---------------

Grout Intervals: From 1 ft. to 33 ft., From _____ ft. to _____ ft., From _____ ft. to _____ ft.

What is the nearest source of possible contamination?

1 Septic tank	4 Lateral lines
2 Sewer lines	5 Cess pool
3 Watertight sewer lines	6 Seepage pit

7 Pit privy
8 Sewage lagoon
9 Feedyard

10 Livestock pens 14 Abandoned water well
11 Fuel storage 15 Oil well/Gas well
12 Fertilizer storage 16 Other (specify below)
13 Insecticide storage Gas tank

Direction from well?

How many feet?

[illegible]

7 CONTRACTOR'S OR LANDOWNER'S CERTIFICATION: This water well was (1) constructed, (2) reconstructed, or (3) plugged under my jurisdiction and was

completed on (mo/day/year) 07/12/05 and this record is true to the best of my knowledge and belief. Kansas
Water Well Contractor's Licence No. 394 This Water Well Record was completed on (mo/day/year) 9/16/05

under the business name of Corporation Great Plains, Tex by (signature) [Signature]