WATER WELL RECORD Form WWC-5 KSA 82a-1212

1 LOCATION OF WATER WELL: County: MEADE | Fraction: NE ¼ NE ¼ SW ¼ | Section Number: 1 | Township Number: T 32 S | Range Number: R 28 E/W

Distance and direction from nearest town or city street address of well if located within city?
1/2 Mile East of Meade, Kansas

2 WATER WELL OWNER: Mr. Pete Cornelson
RR#, St. Address, Box # :
City, State, ZIP Code : Meade, Kansas 67864
Board of Agriculture, Division of Water Resources
Application Number: ---

3 LOCATE WELL'S LOCATION WITH AN "X" IN SECTION BOX:

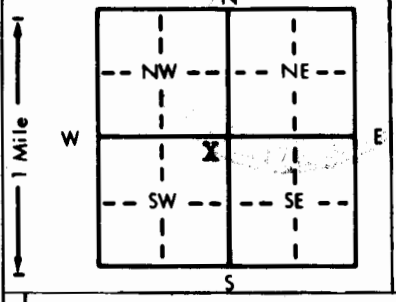

4 DEPTH OF COMPLETED WELL 300 ft. ELEVATION: Slope
Depth(s) Groundwater Encountered 1. Not available ft. 2. ft. 3. ft.
WELL'S STATIC WATER LEVEL 35 ft. below land surface measured on mo/day/yr May 2, 1985
Pump test data: Well water was ft. after hours pumping gpm
Est. Yield XX. 20 gpm: Well water was ft. after hours pumping gpm
Bore Hole Diameter 9 7/8 in. to 300 ft., and in. to ft.
WELL WATER TO BE USED AS: 5 Public water supply 8 Air conditioning 11 Injection well
XX Domestic 3 Feedlot 6 Oil field water supply 9 Dewatering 12 Other (Specify below)
2 Irrigation 4 Industrial 7 Lawn and garden only 10 Observation well
Was a chemical/bacteriological sample submitted to Department? Yes ..... No XX; If yes, mo/day/yr sample was submitted
Water Well Disinfected? Yes XX No

5 TYPE OF BLANK CASING USED: 5 Wrought iron 8 Concrete tile CASING JOINTS: Glued XX Clamped
1 Steel 3 RMP (SR) 6 Asbestos-Cement 9 Other (specify below) Welded
XX PVC 4 ABS 7 Fiberglass Threaded
Blank casing diameter 5 in. to 240 XX ft., Dia in. to ft., Dia in. to ft.
Casing height above land surface 12 in., weight 2.8 lbs./ft. Wall thickness or gauge No. .265
TYPE OF SCREEN OR PERFORATION MATERIAL: XX PVC 10 Asbestos-cement
1 Steel 3 Stainless steel 5 Fiberglass 8 RMP (SR) 11 Other (specify)
2 Brass 4 Galvanized steel 6 Concrete tile 9 ABS 12 None used (open hole)
SCREEN OR PERFORATION OPENINGS ARE: 5 Gauzed wrapped XX Saw cut 11 None (open hole)
1 Continuous slot 3 Mill slot 6 Wire wrapped 9 Drilled holes
2 Louvered shutter 4 Key punched 7 Torch cut 10 Other (specify)
SCREEN-PERFORATED INTERVALS: From 240 ft. to 300 ft., From ft. to ft.
From ft. to ft., From ft. to ft.
GRAVEL PACK INTERVALS: From 14 ft. to 300 ft., From ft. to ft.
From ft. to ft., From ft. to ft.

6 GROUT MATERIAL: XX Neat cement 2 Cement grout 3 Bentonite 4 Other
Grout Intervals: From 4 ft. to 14 ft., From ft. to ft., From ft. to ft.
What is the nearest source of possible contamination:
XX Septic tank 4 Lateral lines 7 Pit privy 10 Livestock pens 14 Abandoned water well
2 Sewer lines 5 Cess pool 8 Sewage lagoon 11 Fuel storage 15 Oil well/Gas well
3 Watertight sewer lines 6 Seepage pit 9 Feedyard 12 Fertilizer storage 16 Other (specify below)
13 Insecticide storage
Direction from well? South How many feet? 100

FROM	TO	LITHOLOGIC LOG	FROM	TO	LITHOLOGIC LOG
0	2	Topsoil			
2	41	Clay			
41	52	Clay and Fine Sand			
52	64	Clay			
64	138	Blue Clay			
138	155	Clay			
155	184	Clay, Fine Sand and Gravel Strips			
184	200	Clay			
200	230	Clay, Fine Sand & Gravel			
230	274	Clay			
274	288	Clay, Fine Sand & Gravel			
288	308	Red Gravel			
308	315	Sandstone			

7 CONTRACTOR'S OR LANDOWNER'S CERTIFICATION: This water well was (1) constructed, (2) reconstructed, or (3) plugged under my jurisdiction and was completed on (mo/day/year) May 3, 1985 and this record is true to the best of my knowledge and belief. Kansas Water Well Contractor's License No. 252 This Water Well Record was completed on (mo/day/yr) May 7, 1985 under the business name of FRIESEN WINDMILL & SUPPLY INC. by (signature)

INSTRUCTIONS: Use typewriter or ball point pen, *PLEASE PRESS FIRMLY* and *PRINT* clearly. Please fill in blanks, underline or circle the correct answers. Send top three copies to Kansas Department of Health and Environment, Division of Environment, Environmental Geology Section, Topeka, KS 66620. Send one to WATER WELL OWNER and retain one for your records.

04-8403738633

OFFICE USE ONLY T R E/W SEC. ¼ ¼ ¼