


1 LOCATION OF WATER WELL: County: **Meade** Fraction: **NW 1/4 NE 1/4 SW 1/4** Section Number: **2** Township Number: **T 32 S** Range Number: **28 EW**

Distance and direction from nearest town or city street address of well if located within city?
50' From the NE Corner of Madison Street & Fowler Street

2 WATER WELL OWNER: **Meade Cooperative Elevator & Supply**
 RR#, St. Address, Box #: **North Highway 23**
 City, State, ZIP Code: **Meade, Ks. 67864**
 Board of Agriculture, Division of Water Resources
 Application Number: _____

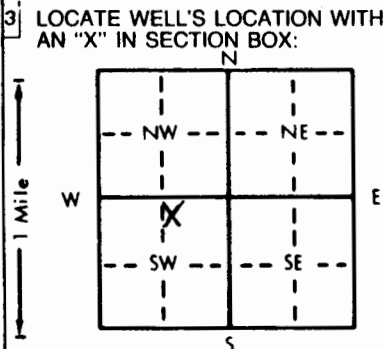

4 DEPTH OF COMPLETED WELL: **55** ft. ELEVATION: **NA**
 Depth(s) Groundwater Encountered 1. **41** ft. 2. _____ ft. 3. _____ ft.
 WELL'S STATIC WATER LEVEL: **41.19** ft. below land surface measured on mo/day/yr **03-22-94**
 Pump test data: Well water was _____ ft. after _____ hours pumping _____ gpm
 Est. Yield _____ gpm: Well water was _____ ft. after _____ hours pumping _____ gpm
 Bore Hole Diameter: **7.5/8** in. to **55** ft., and _____ in. to _____ ft.
 WELL WATER TO BE USED AS:
 5 Public water supply 8 Air conditioning 11 Injection well
 1 Domestic 3 Feedlot 6 Oil field water supply 9 Dewatering 12 Other (Specify below)
 2 Irrigation 4 Industrial 7 Lawn and garden only **10** Monitoring well _____
 Was a chemical/bacteriological sample submitted to Department? Yes _____ No **X**; If yes, mo/day/yr sample was submitted _____
 Water Well Disinfected? Yes _____ No **X**

5 TYPE OF BLANK CASING USED:
 1 Steel 3 RMP (SR) 5 Wrought iron 8 Concrete tile CASING JOINTS: Glued _____ Clamped _____
2 PVC 4 ABS 6 Asbestos-Cement 9 Other (specify below) Welded _____
 7 Fiberglass _____ Threaded **X**
 Blank casing diameter: **2** in. to **35** ft., Dia _____ in. to _____ ft., Dia _____ in. to _____ ft.
 Casing height above land surface: **0** in., weight _____ lbs./ft. Wall thickness or gauge No. **sch. 40**
 TYPE OF SCREEN OR PERFORATION MATERIAL:
 1 Steel 3 Stainless steel 5 Fiberglass 8 RMP (SR) 10 Asbestos-cement
 2 Brass 4 Galvanized steel 6 Concrete tile 9 ABS 11 Other (specify) _____
 12 None used (open hole)
 SCREEN OR PERFORATION OPENINGS ARE:
 1 Continuous slot 3 Mill slot 5 Gauzed wrapped 8 Saw cut 11 None (open hole)
 2 Louvered shutter 4 Key punched 6 Wire wrapped 9 Drilled holes
 7 Torch cut 10 Other (specify) _____
 SCREEN-PERFORATED INTERVALS: From **55** ft. to **35** ft., From _____ ft. to _____ ft.
 From _____ ft. to _____ ft., From _____ ft. to _____ ft.
 GRAVEL PACK INTERVALS: From **55** ft. to **33** ft., From _____ ft. to _____ ft.
 From _____ ft. to _____ ft., From _____ ft. to _____ ft.

6 GROUT MATERIAL: 1 Neat cement 2 Cement grout 3 Bentonite 4 Other _____
 Grout Intervals: From **0** ft. to **31** ft., From **31** ft. to **33** ft., From _____ ft. to _____ ft.
 What is the nearest source of possible contamination:
 1 Septic tank 4 Lateral lines 7 Pit privy 10 Livestock pens 14 Abandoned water well
 2 Sewer lines 5 Cess pool 8 Sewage lagoon 11 Fuel storage 15 Oil well/Gas well
 3 Watertight sewer lines 6 Seepage pit 9 Feedyard 12 Fertilizer storage 16 Other (specify below) _____
 13 Insecticide storage _____
 Direction from well? **south** How many feet? **125**

FROM	TO	LITHOLOGIC LOG	FROM	TO	PLUGGING INTERVALS
0	2'	cly, med brn, mod slty, tr f-c snd & calic			
2'	5'	cly, red-oran brn, mod-v slty, tr snd-grvl szd caliche			
5	8	cly, lt oran-brn, v slty, sl calic, snd-grvl szd			
8	16	cly, lt brn, v slty, sl calic, tr v f med snd			
16	20	cly, med oran-brn, v slty, tr-sl calic			
20	23	cly, lt brn, v slty, sl calic			
23	24	snd, v f-f grnd, sl clyey, v slty			
24	34	cly, lt-med brn, v slty, sl-mod v f-f snd			
34	40	cly, lt oran-mott gry, mod calic, v slty			
40	48	cly, lt-med brn, v slty, sl calic mat, sl v f snd			
48	55	cly, lt gry-white, mod-v lrg arnts of calic, v slty			
					MW3-flush mount cover

7 CONTRACTOR'S OR LANDOWNER'S CERTIFICATION: This water well was **1** constructed, **2** reconstructed, or **3** plugged under my jurisdiction and was completed on (mo/day/year) **03-07-94** and this record is true to the best of my knowledge and belief. Kansas Water Well Contractor's License No. **527** This Water Well Record was completed on (mo/day/yr) **04-18-94** under the business name of **GeoCore Services, Inc.** by (signature) *Dale A. Roll*

INSTRUCTIONS: Use typewriter or ball point pen. PLEASE PRESS FIRMLY and PRINT clearly. Please fill in blanks, underline or circle the correct answers. Send top three copies to Kansas Department of Health and Environment, Bureau of Water, Topeka, Kansas 66620-0001. Telephone: 913-296-5545. Send one to WATER WELL OWNER and retain one for your records.