


1 LOCATION OF WATER WELL: Fraction NW 1/4 NE 1/4 SW 1/4 Section Number 2 Township Number T 32 S Range Number 28 E/W

Distance and direction from nearest town or city street address of well if located within city?  
 50' from the SE Corner of Madison Street & Fowler Street

2 WATER WELL OWNER: Meade Cooperative Elevator & Supply  
 RR#, St. Address, Box #: North Highway 23 Board of Agriculture, Division of Water Resources  
 City, State, ZIP Code: Meade, Ks. 67864 Application Number:

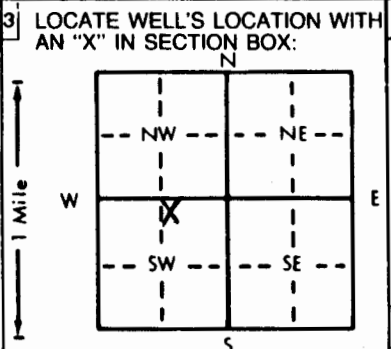

4 DEPTH OF COMPLETED WELL: 55 ft. ELEVATION: NA  
 Depth(s) Groundwater Encountered 1. 41 ft. 2. ft. 3. ft.  
 WELL'S STATIC WATER LEVEL: 41.87 ft. below land surface measured on mo/day/yr 03-22-94  
 Pump test data: Well water was ft. after hours pumping gpm  
 Est. Yield gpm: Well water was ft. after hours pumping gpm  
 Bore Hole Diameter: 7.5/8 in. to 55 ft., and in. to ft.  
 WELL WATER TO BE USED AS:  
 5 Public water supply 8 Air conditioning 11 Injection well  
 1 Domestic 3 Feedlot 6 Oil field water supply 9 Dewatering 12 Other (Specify below)  
 2 Irrigation 4 Industrial 7 Lawn and garden only 10 Monitoring well  
 Was a chemical/bacteriological sample submitted to Department? Yes No X  
 Water Well Disinfected? Yes No X

5 TYPE OF BLANK CASING USED:  
 1 Steel 3 RMP (SR) 5 Wrought iron 8 Concrete tile CASING JOINTS: Glued Clamped  
 2 PVC 4 ABS 6 Asbestos-Cement 9 Other (specify below) Welded X  
 7 Fiberglass Threaded X  
 Blank casing diameter: 2 in. to 35 ft., Dia in. to ft., Dia in. to ft.  
 Casing height above land surface: 0 in., weight lbs./ft. Wall thickness or gauge No. sch. 40

TYPE OF SCREEN OR PERFORATION MATERIAL:  
 1 Steel 3 Stainless steel 5 Fiberglass 8 RMP (SR) 10 Asbestos-cement  
 2 Brass 4 Galvanized steel 6 Concrete tile 9 ABS 11 Other (specify)  
 12 None used (open hole)

SCREEN OR PERFORATION OPENINGS ARE:  
 1 Continuous slot 3 Mill slot 5 Gauzed wrapped 8 Saw cut 11 None (open hole)  
 2 Louvered shutter 4 Key punched 6 Wire wrapped 9 Drilled holes  
 7 Torch cut 10 Other (specify)

SCREEN-PERFORATED INTERVALS: From 55 ft. to 35 ft., From ft. to ft.  
 From ft. to ft., From ft. to ft.  
 GRAVEL PACK INTERVALS: From 55 ft. to 33 ft., From ft. to ft.  
 From ft. to ft., From ft. to ft.

6 GROUT MATERIAL: 1 Neat cement 2 Cement grout 3 Bentonite 4 Other  
 Grout Intervals: From 0 ft. to 31 ft., From 31 ft. to 33 ft., From ft. to ft.

What is the nearest source of possible contamination:  
 1 Septic tank 4 Lateral lines 7 Pit privy 10 Livestock pens 14 Abandoned water well  
 2 Sewer lines 5 Cess pool 8 Sewage lagoon 11 Fuel storage 15 Oil well/Gas well  
 3 Watertight sewer lines 6 Seepage pit 9 Feedyard 12 Fertilizer storage 16 Other (specify below)  
 13 Insecticide storage 40  
 Direction from well? southeast How many feet?

FROM	TO	LITHOLOGIC LOG	FROM	TO	PLUGGING INTERVALS
0	3'	cly, mod-dk brn, mod-v slty, tr f-c snd & snd, grvl szd caliche			
3'	6'	cly, med oran-brn, v slty, sl snd-grvl szd caliche cists			
6	10	cly, lt brn, v slty, sl-mod snd szd caliche			
10	24	cly, lt brn, v slty, sl-mod snd szd caliche, tr of grvl szd calic			
24	27	snd, v f-f grnd, well srted, v slty, sl cly			
27	34	cly, lt-med brn, v slty, sl snd, v f-f grnd			
34	49	cly, lt gry-brn, v slty, mod-v lrg amts of caliche snd-grvl szd			
49	55	cly, lt gry-brn w/yell & green strks, mod-v lrg amts of calic snd-grvl szd			
					MW8-flush mount cover

7 CONTRACTOR'S OR LANDOWNER'S CERTIFICATION: This water well was (1) constructed, (2) reconstructed, or (3) plugged under my jurisdiction and was completed on (mo/day/year) 03-10-94 and this record is true to the best of my knowledge and belief. Kansas Water Well Contractor's License No. 527 This Water Well Record was completed on (mo/day/yr) 04-18-94 under the business name of GeoCore Services, Inc. by (signature) *Ralph A. Roll*

INSTRUCTIONS: Use typewriter or ball point pen. PLEASE PRESS FIRMLY and PRINT clearly. Please fill in blanks, underline or circle the correct answers. Send top three copies to Kansas Department of Health and Environment, Bureau of Water, Topeka, Kansas 66620-0001. Telephone: 913-296-5545. Send one to WATER WELL OWNER and retain one for your records.