


1 LOCATION OF WATER WELL: Fraction NE 1/4 NW 1/4 NE 1/4 Section Number 11 Township Number T 32 S Range Number R 28 EW

Distance and direction from nearest town or city street address of well if located within city? 623 E. Carthage, Meade

2 WATER WELL OWNER: Meade City Municipal Power Plant RR#, St. Address, Box #: 623 E. Carthage City, State, ZIP Code: Meade KS 67864 Board of Agriculture, Division of Water Resources Application Number:

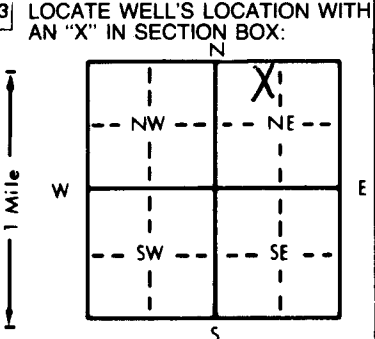

3 LOCATE WELL'S LOCATION WITH AN 'X' IN SECTION BOX: 4 DEPTH OF COMPLETED WELL: 20.0 ft. ELEVATION: 15.0 ft. WELL'S STATIC WATER LEVEL: 12.02 ft. below land surface measured on mo/day/yr 12-11-92

5 TYPE OF BLANK CASING USED: 1 Steel 2 PVC 3 RMP (SR) 4 ABS 5 Wrought iron 6 Asbestos-Cement 7 Fiberglass 8 Concrete tile 9 Other (specify below) 10 Asbestos-cement CASING JOINTS: Glued Clamped Welded Threaded Flush

Blank casing diameter: 2 in. to 2 ft., Dia. Casing height above land surface: Flush in., weight: 703 lbs./ft. Wall thickness or gauge No.: 154

TYPE OF SCREEN OR PERFORATION MATERIAL: 1 Steel 2 Brass 3 Stainless steel 4 Galvanized steel 5 Fiberglass 6 Concrete tile 7 PVC 8 RMP (SR) 9 ABS 10 Asbestos-cement 11 Other (specify) 12 None used (open hole)

SCREEN OR PERFORATION OPENINGS ARE: 1 Continuous slot 2 Louvered shutter 3 Mill slot 4 Key punched 5 Gauzed wrapped 6 Wire wrapped 7 Torch cut 8 Saw cut 9 Drilled holes 10 Other (specify) 11 None (open hole)

SCREEN-PERFORATED INTERVALS: From 10.0 ft. to 20.0 ft. GRAVEL PACK INTERVALS: From 9.0 ft. to 20.0 ft.

6 GROUT MATERIAL: 1 Neat cement 2 Cement grout 3 Bentonite 4 Other Grout Intervals: From 9.0 ft. to 1.0 ft.

What is the nearest source of possible contamination: 1 Septic tank 2 Sewer lines 3 Watertight sewer lines 4 Lateral lines 5 Cess pool 6 Seepage pit 7 Pit privy 8 Sewage lagoon 9 Feedyard 10 Livestock pens 11 Fuel storage 12 Fertilizer storage 13 Insecticide storage 14 Abandoned water well 15 Oil well/Gas well 16 Other (specify below)

Direction from well? North How many feet? 140

Table with columns: FROM, TO, LITHOLOGIC LOG, FROM, TO, PLUGGING INTERVALS. Includes handwritten entries for clay, silty, and sandy layers.

Flush mound waiver granted 12-10-92 for Meade Municipal Plant, KDHE No. 01060027 by Don Taylor

7 CONTRACTOR'S OR LANDOWNER'S CERTIFICATION: This water well was (1) constructed (2) reconstructed, or (3) plugged under my jurisdiction and was completed on (mo/day/year) 12-9-92 and this record is true to the best of my knowledge and belief. Kansas Water Well Contractor's License No. 531 This Water Well Record was completed on (mo/day/yr) 1-4-93 under the business name of GST by (signature) Allison Irwin