


1 LOCATION OF WATER WELL: County: Meade Fraction: NE 1/4 NW 1/4 NE 1/4 Section Number: 11 Township Number: T 32 S Range Number: R 28 EW

Distance and direction from nearest town or city street address of well if located within city?  
623 E. Carthage, Meade

2 WATER WELL OWNER: Meade City Municipal Power Plant  
RR#, St. Address, Box #: 623 E. Carthage  
City, State, ZIP Code: Meade KS 67864  
Board of Agriculture, Division of Water Resources  
Application Number:

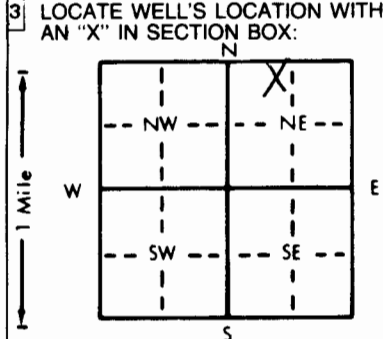

4 DEPTH OF COMPLETED WELL: 20.5 ft. ELEVATION: NA  
Depth(s) Groundwater Encountered 1. 15 ft. 2. ft. 3. ft.  
WELL'S STATIC WATER LEVEL 13.33 ft. below land surface measured on mo/day/yr 12-11-92  
Pump test data: Well water was ft. after hours pumping gpm  
Est. Yield gpm: Well water was ft. after hours pumping gpm  
Bore Hole Diameter: 8 in. to ft., and in. to ft.  
WELL WATER TO BE USED AS:  
5 Public water supply 8 Air conditioning 11 Injection well  
1 Domestic 3 Feedlot 6 Oil field water supply 9 Dewatering 12 Other (Specify below)  
2 Irrigation 4 Industrial 7 Lawn and garden only 10 Monitoring well  
Was a chemical/bacteriological sample submitted to Department? Yes No X; If yes, mo/day/yr sample was submitted  
Water Well Disinfected? Yes No X

5 TYPE OF BLANK CASING USED:  
1 Steel 3 RMP (SR) 5 Wrought iron 8 Concrete tile CASING JOINTS: Glued Clamped  
2 PVC 4 ABS 7 Fiberglass 9 Other (specify below) Welded  
Blank casing diameter in. to ft., Dia. in. to ft., Dia. in. to ft.  
Casing height above land surface: Flush in., weight 703 lbs./ft. Wall thickness or gauge No. 154  
TYPE OF SCREEN OR PERFORATION MATERIAL:  
1 Steel 3 Stainless steel 5 Fiberglass 8 RMP (SR) 10 Asbestos-cement  
2 Brass 4 Galvanized steel 6 Concrete tile 9 ABS 11 Other (specify) 12 None used (open hole)  
SCREEN OR PERFORATION OPENINGS ARE:  
1 Continuous slot 3 Mill slot 5 Gauzed wrapped 8 Saw cut 11 None (open hole)  
2 Louvered shutter 4 Key punched 6 Wire wrapped 9 Drilled holes  
7 Torch cut 10 Other (specify)  
SCREEN-PERFORATED INTERVALS: From 10.5 ft. to 20.5 ft., From ft. to ft.  
GRAVEL PACK INTERVALS: From 9.5 ft. to 20.5 ft., From ft. to ft.  
From ft. to ft., From ft. to ft.

6 GROUT MATERIAL: 1 Neat cement 2 Cement grout 3 Bentonite 4 Other  
Grout intervals: From 9.5 ft. to 10 ft., From ft. to ft., From ft. to ft.  
What is the nearest source of possible contamination:  
1 Septic tank 4 Lateral lines 7 Pit privy 10 Livestock pens 14 Abandoned water well  
2 Sewer lines 5 Cess pool 8 Sewage lagoon 11 Fuel storage 15 Oil well/Gas well  
3 Watertight sewer lines 6 Seepage pit 9 Feedyard 12 Fertilizer storage 16 Other (specify below)  
13 Insecticide storage  
Direction from well? East How many feet? 60

FROM	TO	LITHOLOGIC LOG	FROM	TO	PLUGGING INTERVALS
0.0	5.0	Clay, topsoil			
5.0	10.0	Clay, slightly silty			
10.0	15.0	Clay, silty			
15.0	20.0	Silty, very fine sandstone to sandy siltstone			
20.0	20.5	Very silty sand to sandy silt, very fine grain, well sorted			
Flush Mount Waiver granted 12-10-92 for Meade Municipal Plant, KDHE NO. 01060027 by Don Taylor					

7 CONTRACTOR'S OR LANDOWNER'S CERTIFICATION: This water well was (1) constructed, (2) reconstructed, or (3) plugged under my jurisdiction and was completed on (mo/day/year) 12-9-92 and this record is true to the best of my knowledge and belief. Kansas Water Well Contractor's License No. 537 This Water Well Record was completed on (mo/day/yr) 1-4-93 under the business name of GSI by (signature) Allison Irwin

OFFICE USE ONLY T R EW SEC. 1/4 1/4 1/4