


1 LOCATION OF WATER WELL: County: Meade Fraction: NE 1/4 NW 1/4 NE 1/4 Section Number: 11 Township Number: T 32 S Range Number: R 28 EW

Distance and direction from nearest town or city street address of well if located within city? 623 E Carthage

2 WATER WELL OWNER: Meade Municipal Power Plant
 RR#, St. Address, Box #: 623 E Carthage
 City, State, ZIP Code: Meade KS 67864
 Board of Agriculture, Division of Water Resources
 Application Number: NA

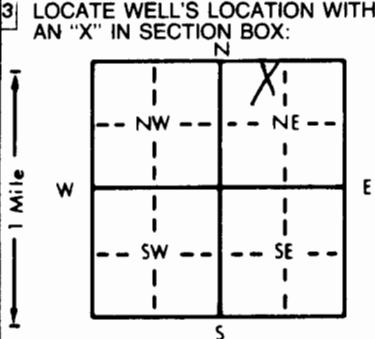

4 DEPTH OF COMPLETED WELL: 25.0 ft. ELEVATION: NA
 Depth(s) Groundwater Encountered: 1 17.5 ft. 2. ft. 3. ft.
 WELL'S STATIC WATER LEVEL: 16.38 ft. below land surface measured on mo/day/yr 12-22-92
 Pump test data: Well water was ft. after hours pumping gpm
 Est. Yield gpm: Well water was ft. after hours pumping gpm
 Bore Hole Diameter: 8 in. to ft., and in. to ft.
 WELL WATER TO BE USED AS:
 1 Domestic 3 Feedlot 6 Oil field water supply 9 Dewatering 12 Other (Specify below)
 2 Irrigation 4 Industrial 7 Lawn and garden only 10 Monitoring well
 Was a chemical/bacteriological sample submitted to Department? Yes No X; If yes, mo/day/yr sample was sub-
 mitted Water Well Disinfected? Yes No X

5 TYPE OF BLANK CASING USED:
 1 Steel 3 RMP (SR) 5 Wrought iron 8 Concrete tile CASING JOINTS: Glued Clamped
2 PVC 4 ABS 6 Asbestos-Cement 9 Other (specify below) Welded
 Blank casing diameter 2 in. to ft., Dia in. to ft., Dia in. to ft.
 Casing height above land surface: Flush in., weight 7.03 lbs./ft. Wall thickness or gauge No. 1.54
 TYPE OF SCREEN OR PERFORATION MATERIAL:
 1 Steel 3 Stainless steel 5 Fiberglass 8 RMP (SR) 10 Asbestos-cement
 2 Brass 4 Galvanized steel 6 Concrete tile 9 ABS 11 Other (specify)
 12 None used (open hole)
 SCREEN OR PERFORATION OPENINGS ARE:
 1 Continuous slot 3 Mill slot 5 Gauzed wrapped 8 Saw cut 11 None (open hole)
 2 Louvered shutter 4 Key punched 6 Wire wrapped 9 Drilled holes
 7 Torch cut 10 Other (specify)
 SCREEN-PERFORATED INTERVALS: From 10.0 ft. to 25.0 ft., From ft. to ft.
 GRAVEL PACK INTERVALS: From 9.0 ft. to 25.0 ft., From ft. to ft.

6 GROUT MATERIAL: 1 Neat cement 2 Cement grout 3 Bentonite 4 Other
 Grout Intervals: From 9.0 ft. to 1.0 ft., From ft. to ft.
 What is the nearest source of possible contamination:
 1 Septic tank 4 Lateral lines 7 Pit privy 10 Livestock pens 14 Abandoned water well
 2 Sewer lines 5 Cess pool 8 Sewage lagoon 11 Fuel storage 15 Oil well/Gas well
 3 Watertight sewer lines 6 Seepage pit 9 Feedyard 12 Fertilizer storage 16 Other (specify below)
 13 Insecticide storage
 Direction from well? South How many feet? 210

FROM	TO	LITHOLOGIC LOG	FROM	TO	PLUGGING INTERVALS
0.0	5.0	Clay, silty			
5.0	10.0	Very silty clay			
10.0	15.0	Sandstone, well sorted			
15.0	20.0	Silty Sandstone			
20.0	25.0	Silty, clayey sandstone			
Flush Mount Waiver granted on 12-22-92 for Meade Municipal Plant; KDHE 01060027 by Don Taylor					

7 CONTRACTOR'S OR LANDOWNER'S CERTIFICATION: This water well was (1) constructed, (2) reconstructed, or (3) plugged under my jurisdiction and was completed on (mo/day/year) 12-22-92 and this record is true to the best of my knowledge and belief. Kansas Water Well Contractor's License No. 531 This Water Well Record was completed on (mo/day/yr) 1-11-93 under the business name of GSI by (signature) Allison J. Irwin

OFFICE USE ONLY T R EW SEC. 1/4 1/4 1/4