


1 LOCATION OF WATER WELL: County: MEADE Fraction: SW 1/4 SW 1/4 NE 1/4 Section Number: 15 Township Number: T 32 S Range Number: R 28 **EW**

Distance and direction from nearest town or city street address of well if located within city?

1 Mile South, 1/2 West of Meade, KS

2 WATER WELL OWNER: Meade Golf Course
 RR#, St. Address, Box #: c/o Roy Twist
 City, State, ZIP Code: Meade, KS 67864
 Board of Agriculture, Division of Water Resources
 Application Number: 39,377

3 LOCATE WELL'S LOCATION WITH AN "X" IN SECTION BOX:

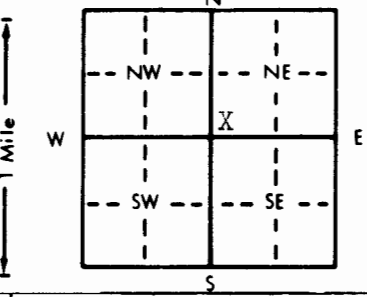

4 DEPTH OF COMPLETED WELL: 347 ft. ELEVATION: Slope
 Depth(s) Groundwater Encountered: 1. Not available ft. 2. ft. 3. ft.
 WELL'S STATIC WATER LEVEL: 105 ft. below land surface measured on mo/day/yr Sep. 27, 1989
 Pump test data: Well water was ft. after hours pumping gpm
 Est. Yield 100 gpm: Well water was ft. after hours pumping gpm
 Bore Hole Diameter: 10 in. to 347 ft., and in. to ft.
 WELL WATER TO BE USED AS:
 5 Public water supply 8 Air conditioning 11 Injection well
 1 Domestic 3 Feedlot 6 Oil field water supply 9 Dewatering 12 Other (Specify below)
 Irrigation 4 Industrial 7 Lawn and garden only 10 Monitoring well
 Was a chemical/bacteriological sample submitted to Department? Yes No If yes, mo/day/yr sample was submitted
 Water Well Disinfected? Yes No

5 TYPE OF BLANK CASING USED:
 1 Steel 3 RMP (SR)
 PVC 4 ABS
 5 Wrought iron 8 Concrete tile CASING JOINTS: Glued Clamped
 6 Asbestos-Cement 9 Other (specify below) Welded
 7 Fiberglass Threaded

Blank casing diameter: 6 in. to 270 ft., Dia. in. to ft., Dia. in. to ft.
 Casing height above land surface: 18 in., weight 4.0 lbs./ft. Wall thickness or gauge No. 316

TYPE OF SCREEN OR PERFORATION MATERIAL:
 1 Steel 3 Stainless steel 5 Fiberglass 8 RMP (SR)
 2 Brass 4 Galvanized steel 6 Concrete tile 9 ABS 12 None used (open hole)
 PVC 10 Asbestos-cement
 11 Other (specify)

SCREEN OR PERFORATION OPENINGS ARE:
 1 Continuous slot 3 Mill slot 5 Gauzed wrapped 8 Saw cut 11 None (open hole)
 2 Louvered shutter 4 Key punched 6 Wire wrapped 9 Drilled holes
 7 Torch cut 10 Other (specify)

SCREEN-PERFORATED INTERVALS: From 270 ft. to 347 ft., From ft. to ft.
 From ft. to ft., From ft. to ft.
 GRAVEL PACK INTERVALS: From 20 ft. to 347 ft., From ft. to ft.
 From ft. to ft., From ft. to ft.

6 GROUT MATERIAL: 1 Neat cement 2 Cement grout 3 Bentonite Other: Baroid Hole Plug
 Grout Intervals: From 0 ft. to 20 ft., From ft. to ft., From ft. to ft.

What is the nearest source of possible contamination: NONE
 1 Septic tank 4 Lateral lines 7 Pit privy 11 Fuel storage 15 Oil well/Gas well
 2 Sewer lines 5 Cess pool 8 Sewage lagoon 12 Fertilizer storage 16 Other (specify below)
 3 Watertight sewer lines 6 Seepage pit 9 Feedyard 13 Insecticide storage

Direction from well? How many feet?

FROM	TO	LITHOLOGIC LOG	FROM	TO	PLUGGING INTERVALS
0	3	Topsoil			
3	135	Clay			
135	145	Fine Sand			
145	175	Blue Clay			
175	210	Black Clay			
210	220	Red Clay			
220	239	Red Clay & Med. Gravel			
239	255	Med. Sand & Gravel			
255	261	Clay			
261	275	Med. Sand & Gravel			
275	320	Clay			
320	350	Med. Sand & Gravel			

7 CONTRACTOR'S OR LANDOWNER'S CERTIFICATION: This water well was (1) constructed, (2) reconstructed, or (3) plugged under my jurisdiction and was completed on (mo/day/year) September 27, 1989 and this record is true to the best of my knowledge and belief. Kansas Water Well Contractor's License No. 252 This Water Well Record was completed on (mo/day/year) October 9, 1989 under the business name of FRIESEN WINDMILL & SUPPLY INC. by (signature) [Signature]

1010000069-50

OFFICE USE ONLY
T
R
EW
SEC.