USE TYPEWRITER OR BALL POINT PEN-PRESS FIRMLY, PRINT CLEARLY.

WATER WELL RECORD
KSA 82a-1201-1215

Kansas Department of Health and Environment-Division of Environment
(Water well Contractors)
Topeka, Kansas 66620

CWW Inv. #13848 Crooked L-#1-20

1. Location of well:	County	Fraction	Section number	Township number	Range number
	Meade	1/4 SE 1/4 SE 1/4	20	T 32S S	R 28W E/W

2. Distance and direction from nearest town or city: From Meade, Ks go 2 mi. South - 2 mi. West - 1 mi. South - ¾ mi. West - North to Loct.
Street address of well location if in city:

3. Owner of well: Sage Drilling Company
R.R. or street: 500 Bitting Building
City, state, zip code: Wichita, Kansas 67202

4. Locate with "X" in section below:

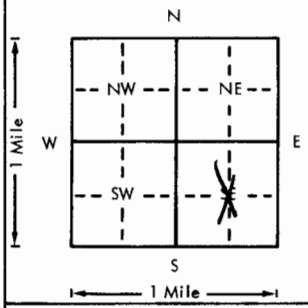

Sketch map:

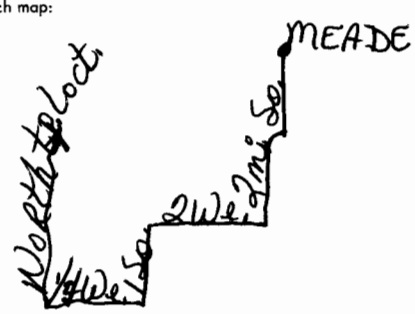

6. Bore hole dia. 9 in. Completion date 9-20
Well depth 180 ft.

7. __ Cable tool X Rotary __ Driven __ Dug
__ Hollow rod __ Jetted __ Bored __ Reverse rotary

8. Use: __ Domestic __ Public supply X Industry
__ Irrigation __ Air conditioning __ Stock
__ Lawn X Oil field water __ Other

9. Casing: Material ____ Height: Above or below
Threaded ____ Welded ____ Surface 28 in.
RMP ____ PVC X Weight 2.78 lbs./ft.
Dia. 5 in. to 95 ft. depth Wall Thickness: inches or
Dia. 5 in. to 180 ft. depth gage No. .265

5. Type and color of material	From	To
Surface	0	2
Clay	2	20
Medium to large sand	20	60
Clay	60	100
Fine sand & medium to large sand	100	158
Clay, Medium to large sand, blue, 30%	158	180
(Use a second sheet if needed)		

10. Screen: Manufacturer's name Sawed Perf.
Type PVC Dia. 5"
Slot/gauze ____ Length 80'
Set between 95 ft. and 175 ft.
____ ft. and ____ ft.
Gravel pack? yes Size range of material 1/8-3/16

11. Static water level: mo./day/yr.
60 ft. below land surface Date 9/20/77

12. Pumping level below land surfaces:
____ ft. after ____ hrs. pumping ____ g.p.m.
____ ft. after ____ hrs. pumping ____ g.p.m.
Estimated maximum yield 60 g.p.m.

13. Water sample submitted: mo./day/yr.
__ Yes X No Date ____

14. Well head completion:
__ Pitless adapter 28 Inches above grade

15. Well grouted? Yes
With: XX Neat cement ____ Bentonite ____ Concrete
Depth: From 0 ft. to 10 ft.

16. Nearest source of possible contamination:
ft. NE Direction 100 Type oilwell
Well disinfected upon completion? X Yes ____ No

17. Pump: X Not installed
Manufacturer's name ____
Model number ____ HP ____ Volts ____
Length of drop pipe ____ ft. capacity ____ g.p.m.
Type:
__ Submersible __ Turbine
__ Jet __ Reciprocating
__ Centrifugal __ Other

T 32 R 28 E (W) Sec 20 1/4 SE 1/4 1/4 1/4

18. Elevation:

Topography:
__ Hill
__ Slope
X Upland
__ Valley

19. Remarks:

20. Water well contractor's certification:
This well was drilled under my jurisdiction and this report is true to the best of my knowledge and belief.
Carlile Water Well 118
Business name License No.
Address Box 275, Liberal, KS
Signed Edward E. Meeno Date 10/4/77
Authorized representative

Forward the white, blue and pink copies to the Department of Health and Environment

Form WWC-5

MI-1023