


1 LOCATION OF WATER WELL: County: Meade Fraction: SW 1/4 SW 1/4 NE 1/4 Section Number: 30 Township Number: T 32 S Range Number: R 28 E00

Distance and direction from nearest town or city street address of well if located within city?  
3 1/2 S + 3 1/2 W of Meade

2 WATER WELL OWNER: Kirby Clawson  
 RR#, St. Address, Box # : \_\_\_\_\_ Board of Agriculture, Division of Water Resources  
 City, State, ZIP Code : \_\_\_\_\_ Application Number: \_\_\_\_\_

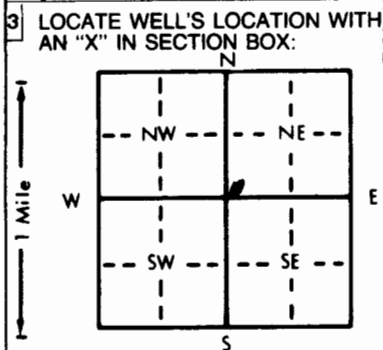

4 DEPTH OF COMPLETED WELL: 260 ft. ELEVATION: \_\_\_\_\_  
 Depth(s) Groundwater Encountered 1. \_\_\_\_\_ ft. 2. \_\_\_\_\_ ft. 3. \_\_\_\_\_ ft.  
 WELL'S STATIC WATER LEVEL 90 ft. below land surface measured on mo/day/yr 7-12-93  
 Pump test data: Well water was 90 ft. after 1 hours pumping 30 gpm  
 Est. Yield 50 gpm: Well water was \_\_\_\_\_ ft. after \_\_\_\_\_ hours pumping \_\_\_\_\_ gpm  
 Bore Hole Diameter: 8 3/4 in. to 260 ft., and \_\_\_\_\_ in. to \_\_\_\_\_ ft.  
 WELL WATER TO BE USED AS:  
 Domestic     Feedlot     Oil field water supply     Dewatering     12 Other (Specify below)  
 2 Irrigation     4 Industrial     7 Lawn and garden only     10 Monitoring well  
 Was a chemical/bacteriological sample submitted to Department? Yes \_\_\_\_\_ No  If yes, mo/day/yr sample was submitted \_\_\_\_\_  
 Water Well Disinfected? Yes  No \_\_\_\_\_

5 TYPE OF BLANK CASING USED:  
 Steel     3 RMP (SR)     6 Asbestos-Cement     9 Other (specify below)     Welded  
 PVC     4 ABS     7 Fiberglass    \_\_\_\_\_     Threaded  
 Blank casing diameter 5 in. to 220 ft., Dia \_\_\_\_\_ in. to \_\_\_\_\_ ft., Dia \_\_\_\_\_ in. to \_\_\_\_\_ ft.  
 Casing height above land surface 24 in., weight \_\_\_\_\_ lbs./ft. Wall thickness or gauge No. 20016  
 TYPE OF SCREEN OR PERFORATION MATERIAL:  
 1 Steel     3 Stainless steel     5 Fiberglass     8 RMP (SR)     11 Other (specify) \_\_\_\_\_  
 2 Brass     4 Galvanized steel     6 Concrete tile     9 ABS     12 None used (open hole)  
 SCREEN OR PERFORATION OPENINGS ARE:  
 1 Continuous slot     3 Mill slot     6 Wire wrapped     Saw cut     11 None (open hole)  
 2 Louvered shutter     4 Key punched     7 Torch cut     9 Drilled holes  
 SCREEN-PERFORATED INTERVALS: From 220 ft. to 260 ft., From \_\_\_\_\_ ft. to \_\_\_\_\_ ft.  
 From \_\_\_\_\_ ft. to \_\_\_\_\_ ft., From \_\_\_\_\_ ft. to \_\_\_\_\_ ft.  
 GRAVEL PACK INTERVALS: From 20 ft. to 220 ft., From \_\_\_\_\_ ft. to \_\_\_\_\_ ft.  
 From \_\_\_\_\_ ft. to \_\_\_\_\_ ft., From \_\_\_\_\_ ft. to \_\_\_\_\_ ft.

6 GROUT MATERIAL:  1 Neat cement     Cement grout     3 Bentonite     4 Other \_\_\_\_\_  
 Grout Intervals: From 14 ft. to 20 ft., From \_\_\_\_\_ ft. to \_\_\_\_\_ ft., From \_\_\_\_\_ ft. to \_\_\_\_\_ ft.  
 What is the nearest source of possible contamination:  
 1 Septic tank     4 Lateral lines     7 Pit privy     10 Livestock pens     Abandoned water well  
 2 Sewer lines     5 Cess pool     8 Sewage lagoon     11 Fuel storage     15 Oil well/Gas well  
 3 Watertight sewer lines     6 Seepage pit     9 Feedyard     12 Fertilizer storage     16 Other (specify below)  
 13 Insecticide storage  
 Direction from well? NE How many feet? 40

FROM	TO	LITHOLOGIC LOG	FROM	TO	PLUGGING INTERVALS
0	5	Topsoil			
5	10	brown clay			
10	15	sand			
15	30	brown clay			
30	70	sand			
70	140	gray clay			
140	195	blue clay			
195	260	sand & gravel			

7 CONTRACTOR'S OR LANDOWNER'S CERTIFICATION: This water well was  constructed, (2) reconstructed, or (3) plugged under my jurisdiction and was completed on (mo/day/year) 7-12-93 and this record is true to the best of my knowledge and belief. Kansas Water Well Contractor's License No. 101 This Water Well Record was completed on (mo/day/yr) 7-28-93 under the business name of Bartel Well Drilling, Inc by (signature) Reuben J. Bartel

INSTRUCTIONS: Use typewriter or ball point pen. PLEASE PRESS FIRMLY and PRINT clearly. Please fill in blanks, underline or circle the correct answers. Send top three copies to Kansas Department of Health and Environment, Bureau of Water, Topeka, Kansas 66620-0001. Telephone: 913-296-5545. Send one to WATER WELL OWNER and retain one for your records.

OFFICE USE ONLY  
T  
R  
EW  
SEC.