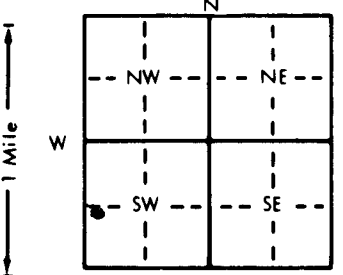


1 LOCATION OF WATER WELL: Fraction NW 1/4 SW 1/4 SW 1/4 Section Number 22 Township Number T 32 S Range Number R 28 EW  
 County: Meade

Distance and direction from nearest town or city street address of well if located within city?  
MEADE - 2 mi South on Hwy 23 - 1 mi West - 3/4 mi South + East ->

2 WATER WELL OWNER: Kim Batman  
 RR#, St. Address, Box #: Box 659 Board of Agriculture, Division of Water Resources  
 City, State, ZIP Code: Meade, KS 67864 Application Number:

3 LOCATE WELL'S LOCATION WITH AN "X" IN SECTION BOX:  
  
 4 DEPTH OF COMPLETED WELL: 260 ft. ELEVATION:  
 Depth(s) Groundwater Encountered 1. 24 ft. 2. ft. 3. ft.  
 WELL'S STATIC WATER LEVEL 24 ft. below land surface measured on mo/day/yr 7-25-98  
 Pump test data: Well water was ft. after hours pumping gpm  
 Est. Yield gpm Well water was ft. after hours pumping gpm  
 Bore Hole Diameter 12 1/4 in. to 20 ft., and 9 1/4 in. to 260 ft.  
 WELL WATER TO BE USED AS:  
 1 Domestic 3 Feedlot 6 Oil field water supply 9 Dewatering 12 Other (Specify below)  
 2 Irrigation 4 Industrial 7 Lawn and garden only 10 Monitoring well  
 Was a chemical/bacteriological sample submitted to Department? Yes No X; If yes, mo/day/yr sample was submitted  
 Water Well Disinfected? Yes X No

5 TYPE OF BLANK CASING USED:  
 1 Steel 3 RMP (SR) 5 Wrought iron 8 Concrete tile CASING JOINTS: Glued Clamped  
 2 PVC 4 ABS 6 Asbestos-Cement 9 Other (specify below) Welded  
 7 Fiberglass Threaded  
 Blank casing diameter 5.56 in. to 200 ft., Dia. in. to ft., Dia. in. to ft.  
 Casing height above land surface 30 in., weight 200 lbs./ft. Wall thickness or gauge No. SDR-21  
 TYPE OF SCREEN OR PERFORATION MATERIAL:  
 1 Steel 3 Stainless steel 5 Fiberglass 8 RMP (SR) 10 Asbestos-cement  
 2 Brass 4 Galvanized steel 6 Concrete tile 9 ABS 12 None used (open hole)  
 SCREEN OR PERFORATION OPENINGS ARE:  
 1 Continuous slot 3 Mill slot 0.032 6 Wire wrapped 9 Drilled holes 11 None (open hole)  
 2 Louvered shutter 4 Key punched 7 Torch cut 10 Other (specify)  
 SCREEN-PERFORATED INTERVALS: From 200 ft. to 260 ft., From ft. to ft.  
 GRAVEL PACK INTERVALS: From 195 ft. to 260 ft., From ft. to ft.

6 GROUT MATERIAL: 1 Neat cement 2 Cement grout 3 Bentonite 4 Other  
 Grout Intervals: From 4 ft. to 22 ft., From ft. to ft., From 185 ft. to 195 ft.  
 What is the nearest source of possible contamination:  
 1 Septic tank 4 Lateral lines 7 Pit privy 11 Fuel storage 14 Abandoned water well  
 2 Sewer lines 5 Cess pool 8 Sewage lagoon 12 Fertilizer storage 15 Oil well/Gas well  
 3 Watertight sewer lines 6 Seepage pit 9 Feedyard 13 Insecticide storage 16 Other (specify below)  
 Direction from well? How many feet? 75

FROM	TO	LITHOLOGIC LOG	FROM	TO	PLUGGING INTERVALS
0	14	Topsoil			
14	21	Caliche & Brown Sandy Clay			
21	27	Tan Sandy Clay			
27	35	Tan Sandy Clay w/ med. sand			
35	38	Brown Sandy Clay			
38	49	Tan, Yellow & Blue Clay			
49	55	Blue Sandy Clay w/ sand streaks			
55	187	Blue + Black clay			
187	218	med. to coarse sand			
218	223	Yellow clay w/ sand streaks			
223	238	Tan Sandy Clay			
238	251	Fine to med. sand			
251	260	Tan Clay			

7 CONTRACTOR'S OR LANDOWNER'S CERTIFICATION: This water well was (1) constructed, (2) reconstructed, or (3) plugged under my jurisdiction and was completed on (mo/day/year) 7-25-98 and this record is true to the best of my knowledge and belief. Kansas Water Well Contractor's License No. 600-A This Water Well Record was completed on (mo/day/yr) 7-28-98 under the business name of Cramer Drilling Co. by (signature) Kelly Cramer

INSTRUCTIONS: Use typewriter or ball point pen. PLEASE PRESS FIRMLY and PRINT clearly. Please fill in blanks, underline or circle the correct answers. Send top three copies to Kansas Department of Health and Environment, Bureau of Water, Topeka, Kansas 66620-0001. Telephone: 913-296-5545. Send one to WATER WELL OWNER and retain one for your records.

RECEIVED  
 JUL 31 1998  
 BUREAU OF WATER

OFFICE USE ONLY  
 T  
 R  
 EW  
 SEC.  
 1/4  
 1/4  
 1/4