

WATER WELL PLUGGING RECORD Form WWC-5P

KSA 82a-1212

ID NO.

1 LOCATION OF WATER WELL: County: <u>Meade</u> Street/Rural Address of Well Location; if unknown, distance & direction from nearest town or intersection: If at owner's address, check here ☐ <u>923 W Carthage Ave, Meade, KS 67864</u>	Fraction SW 1/4 NW 1/4 NE 1/4 NE 1/4	Section Number <u>10</u>	Township Number T <u>32</u> S	Range Number <u>28</u> ☐ E ☒ W
---	---	-----------------------------	----------------------------------	--

Global Positioning Systems (GPS) information:
 Latitude: 37.28520422 (in decimal degrees)
 Longitude: 100.3490492 (in decimal degrees)
 Elevation: _____
 Datum: ☐ WGS84, ☒ NAD83, ☐ NAD27
 Collection Method: _____
☐ GPS unit (Make/Model: _____)
☐ Digital Map/Photo, ☐ Topographic Map, ☐ Land Survey
 Est. Accuracy: ☐ < 3 m, ☐ 3-5 m, ☐ 5-15 m, ☐ > 15 m

2 WATER WELL OWNER: Meade Coop Elevator RR#, St. Address, Box #: <u>PO Box 220</u> City, State ZIP Code: <u>Meade, KS 67864</u>	3 MARK WELL'S LOCATION WITH AN "X" IN SECTION BOX:
--	---

4 DEPTH OF WELL 53.37/51.10 ft.
 WELL'S STATIC WATER LEVEL Dry/Dry ft.
 WELL WAS USED AS:

☐ Domestic	☐ Public Water Supply	☐ Dewatering
☐ Irrigation	☐ Oil Field Water Supply	☐ Monitoring
☐ Feedlot	☐ Domestic (Lawn & Garden)	☐ Injection Well
☐ Industrial	☐ Air Conditioning	☒ Other <u>SVE</u>

 Was a chemical/bacteriological sample submitted to Department? Yes ☐ No ☒

5 TYPE OF BLANK CASING USED:

☐ Steel	☐ RMP (SR)	☐ Wrought	☐ Fiberglass	☐ Other (Specify below) _____
☒ PVC	☐ ABS	☐ Asbestos-Cement	☐ Concrete Tile	

 Blank casing diameter 4/2 in. Was casing pulled? Yes ☐ No ☒ If yes, how much _____
 Casing height above or below land surface 36 in.

6 GROUT PLUG MATERIAL: ☐ Neat cement ☐ Cement grout ☒ Bentonite ☐ Other _____
 Grout Plug Intervals: From 3 ft. to 53.37 ft., From 3 ft. to 51.10 ft., From _____ to _____ ft.
 What is the nearest source of possible contamination:


☐ Septic tank	☐ Seepage pit	☐ Fuel Storage	☒ Other (specify below) _____
☐ Sewer lines	☐ Pit privy	☐ Fertilizer storage	Lust Site _____
☐ Watertight sewer lines	☐ Sewage lagoon	☐ Insecticide storage	
☐ Lateral lines	☐ Feedyard	☐ Abandoned water well	Direction from well? _____
☐ Cess pool	☐ Livestock pens	☐ Oil well/Gas well	How many feet? _____

FROM	TO	PLUGGING MATERIALS	FROM	TO	PLUGGING MATERIALS
0	3	Native Surface	0	3	Native Surface
3	53.37	Bentonite Grout	3	51.10	Bentonite Grout
					SVE/AS4

7 CONTRACTOR'S OR LANDOWNER'S CERTIFICATION: This water well was plugged under my jurisdiction and was completed on (mo/day/year) 4/26/2013 and this record is true to the best of my knowledge and belief. Kansas Water Well Contractor's License No. 594. This Water Well Record was completed on (mo/day/year) 5/10/2013 under the business name of Coranco Great Plains Inc. by (signature) [Signature]

INSTRUCTIONS: Use typewriter or ballpoint pen. Please press firmly and print clearly. Please fill in blanks, underline or circle the correct answers. Send top three copies to Kansas Department of Health and Environment, Bureau of Water, Geology Section, 1000 SW Jackson St., Ste. 420, Topeka, Kansas 66612-1367. Telephone: 785/296-5524. Send one to Water Well Owner and retain one for your records. Visit us at <http://www.kdheks.gov/waterwell/index.html>.

Check one: ☐ White Copy ☐ Blue Copy ☐ Pink Copy

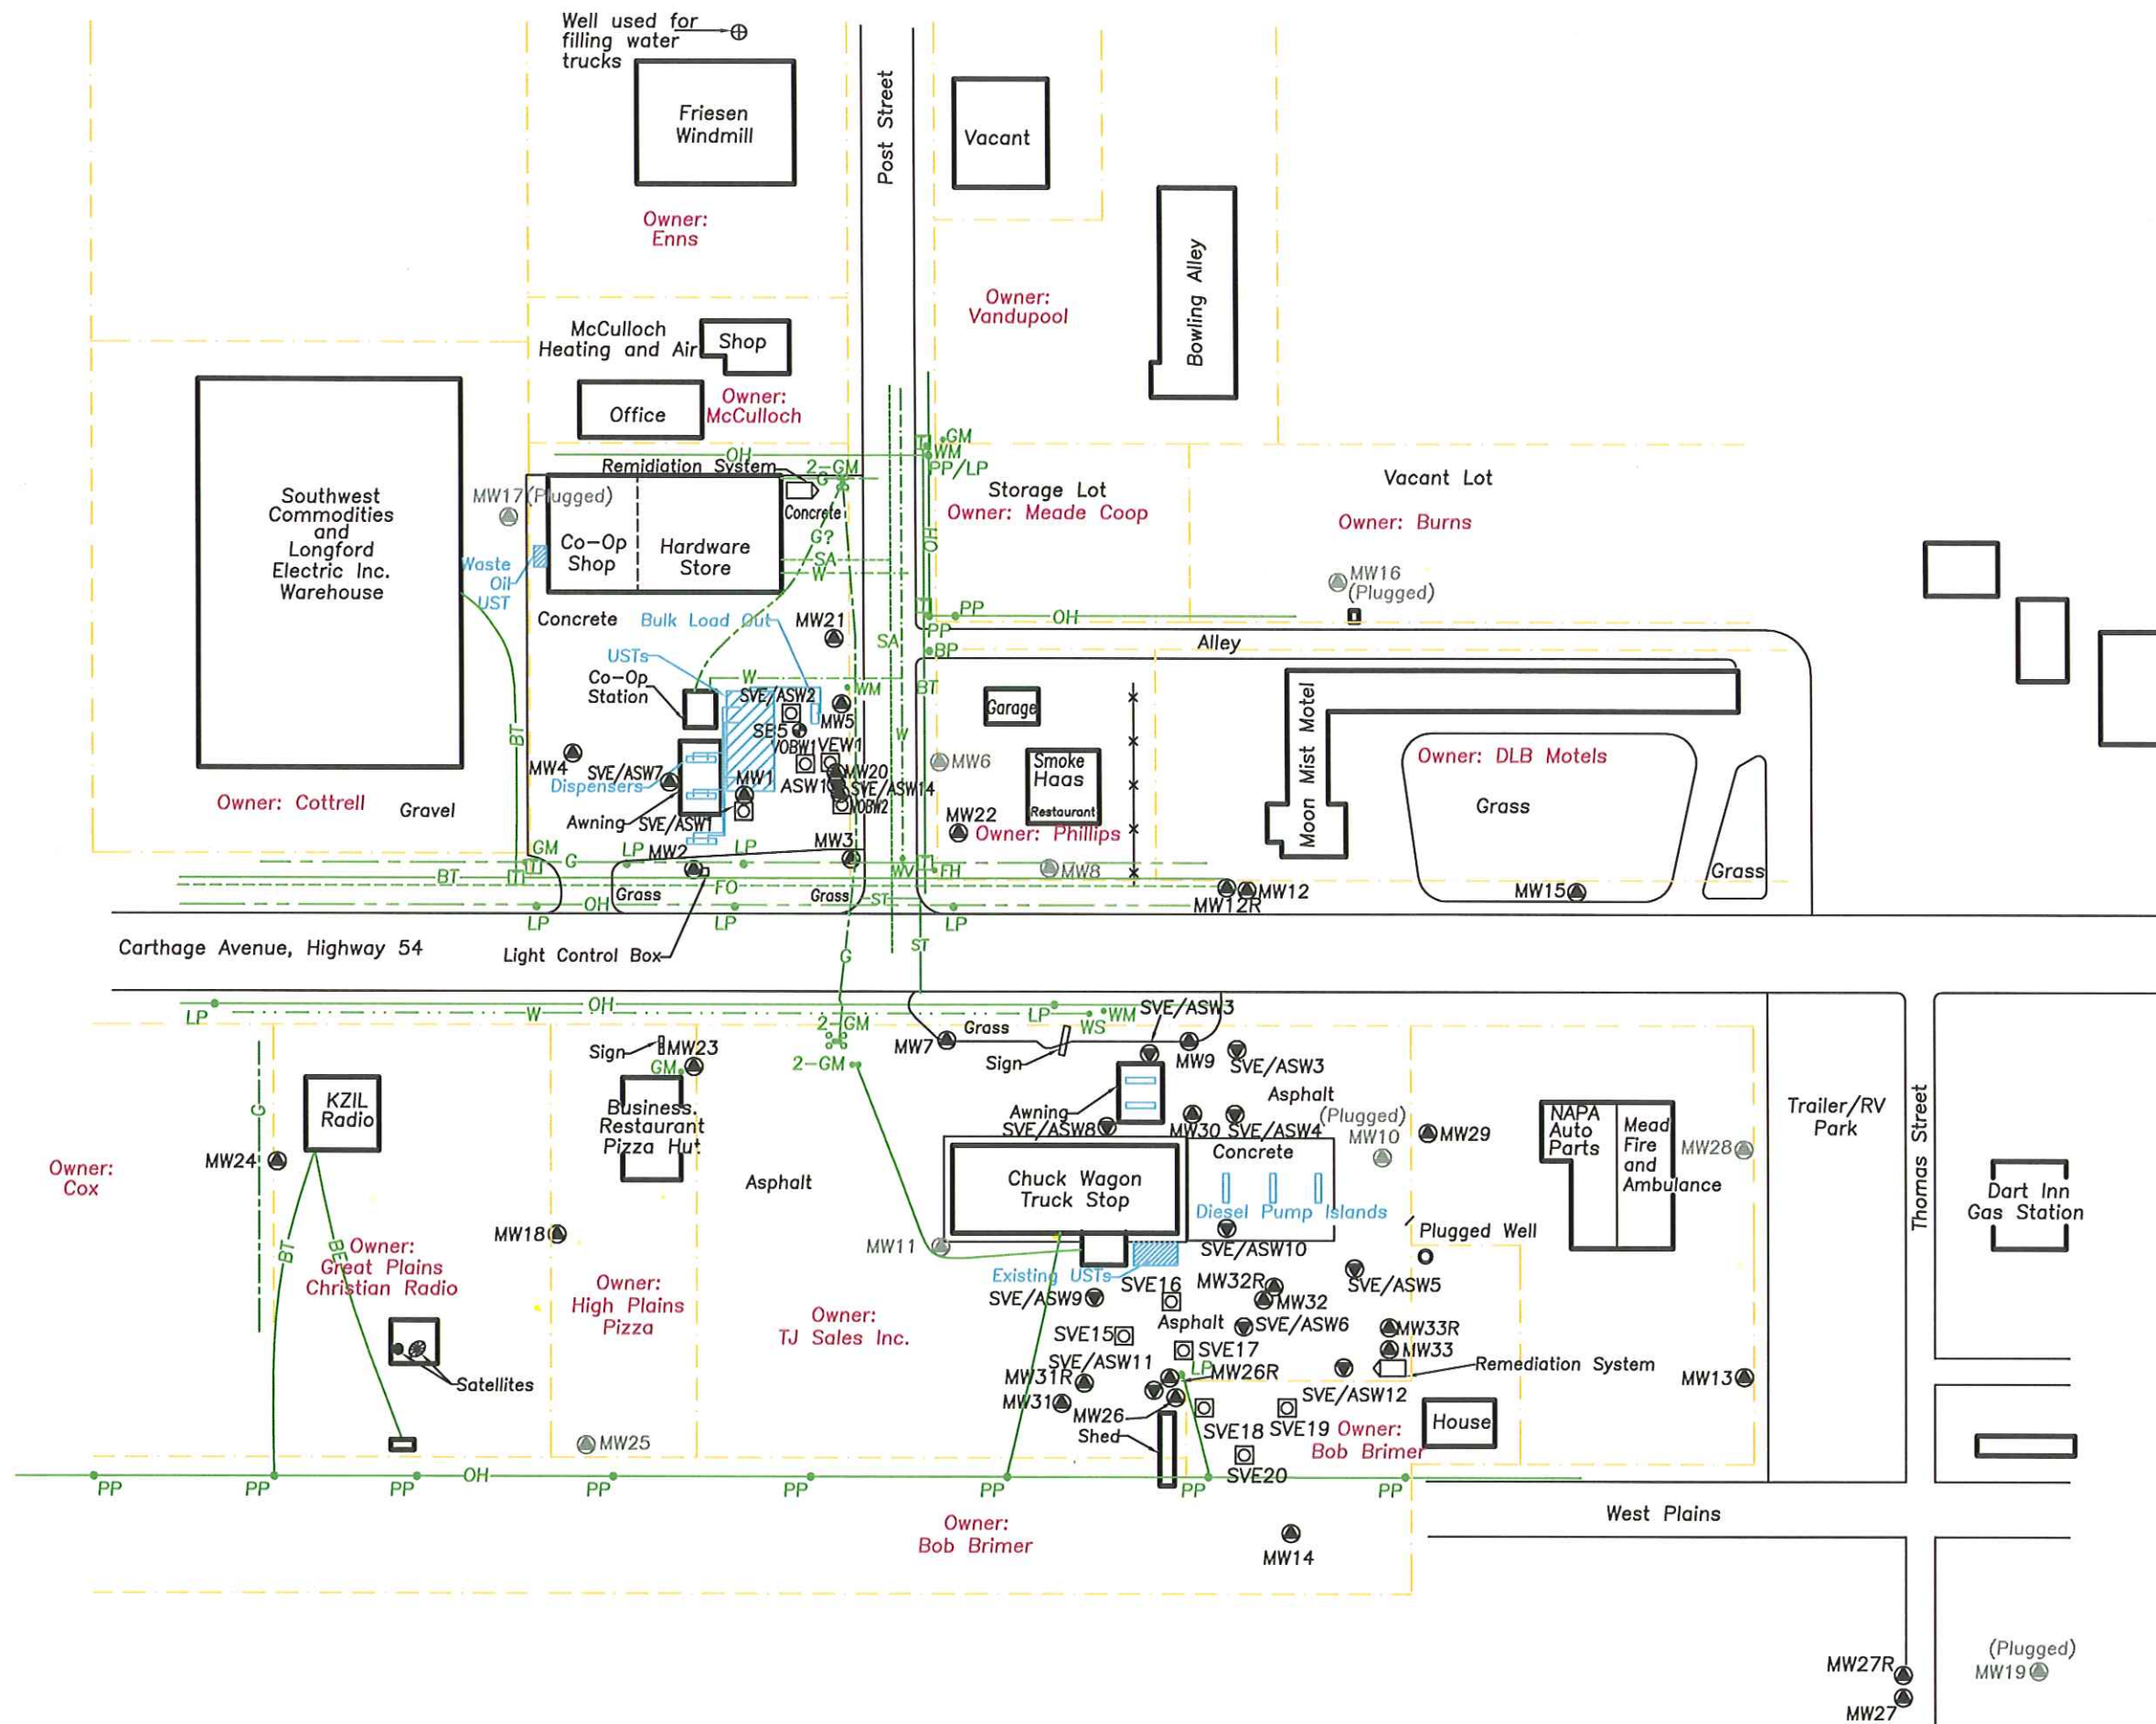

Legend

- MW5 - Monitoring Well Location
- SB3 - Soil Boring Location
- ASW1 - Air Sparge Well Location
- VOBW1 - Vapor Observation Well
- SVE1 - Soil Vapor Extraction Well
- MW11 - Destroyed/Abandoned Well
- Property Line
- OH— Overhead Electric
- FO— Fiber Optic (~ 24"deep)
- BT— Buried Telephone (~ 24"deep)
- W— Water Line (~ 48"deep)
- SA— Sanitary Sewer (~ 60"deep)
- ST— Storm Sewer (~ 12"deep)
- G— Natural Gas (~ 30"deep)
- BE— Buried Electric
- PP - Power Pole
- LP - Light Pole
- BP - Brace Pole
- GM - Gas Meter
- WM - Water Meter
- WV - Water Valve
- WS - Water Spigot
- FH - Fire Hydrant
- - Steel Bollard
- - Telephone Pedestal

Scale In Feet
0 120 240

Site Base Map
Meade Coop
Meade, KS
Quarterly Monitoring Report
GCP Project #97013
Prepared By: RH Date: 06-11-12
Reviewed By: LD Date: 06-11-12
Figure 1
Coranco Great Plains, Inc. PO Box 23, Wahoo, NE 68066