

WATER WELL PLUGGING RECORD

Form WWC-5P

KSA 82a-1212

ID No.

VP-20


1 LOCATION OF WATER WELL:	Fraction	Section Number	Township Number	Range Number
County: Meade	NE 1/4 NW 1/4 NE 1/4	11	32S	28W

Distance and direction from nearest town or city street address of well if located within city?  
623 E. Carthage, Meade, KS 67864

2 WATER WELL OWNER: Meade Municipal Plant  
RR#, St. Address, Box # 623 East Carthage St.  
City, State, ZIP Code : Meade, KS 67864

Board of Agriculture, Division of Water Resources  
Application Number:

3 MARK WELL'S LOCATION WITH AN "X" IN SECTION BOX:

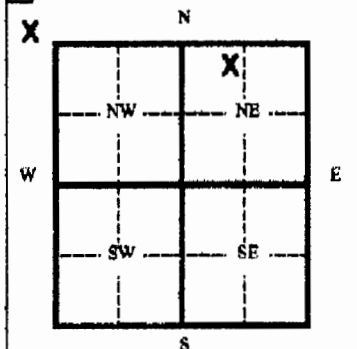

4 DEPTH OF WELL 19.5 ft.  
WELL'S STATIC WATER LEVEL \_\_\_\_\_ ft.  
WELL WAS USED AS:  
1 Domestic 5 Public Water Supply 9 Dewatering  
2 Irrigation 6 Oil Field Water Supply 10 Monitoring Well  
3 Feedlot 7 Lawn and Garden (domestic) 11 Injection Well  
4 Industrial 8 Air Conditioning 12 Other \_\_\_\_\_

Was a chemical/bacteriological sample submitted to Department? Yes \_\_\_ No \_\_\_  
If yes, mo/day/yr sample was submitted \_\_\_\_\_  
Water Well Disinfected: Yes \_\_\_ No \_\_\_

5 TYPE OF BLANK CASING USED:  
1 Steel 3 RMP (SR) 5 Wrought 7 Fiberglass 9 Other (specify below)  
2 PVC 4 ABC 6 Asbestos-Cement 8 Concrete Tile  
Blank casing diameter 2 in. Was casing pulled? Yes  No \_\_\_ If yes, how much \_\_\_\_\_ 3 feet  
Casing height above or below land surface \_\_\_\_\_ in.

6 GROUT PLUG MATERIAL: 1 Neat cement 2 Cement grout 3 Bentonite 4 Other \_\_\_\_\_  
Grout Plug Intervals From \_\_\_\_\_ ft. to \_\_\_\_\_ ft. From \_\_\_\_\_ ft. to \_\_\_\_\_ ft. From \_\_\_\_\_ ft. to \_\_\_\_\_ ft.  
What is the nearest source of possible contamination:  
1 Septic tank 6 Seepage pit 11 Fuel storage 16 Other (specify below)  
2 Sewer lines 7 Pit privy 12 Fertilizer storage  
3 Watertight sewer lines 8 Sewage lagoon 13 Insecticide storage  
4 Lateral lines 9 Feedyard 14 Abandoned water well  
5 Cess Pool 10 Livestock pens 15 Oil well/ Gas well

Direction from well? \_\_\_\_\_ How many feet? \_\_\_\_\_

FROM	TO	CODE	PLUGGING MATERIALS
0	3'		Native
3'	19.5'		Bentonite Chips

7 CONTRACTOR'S OR LANDOWNER'S CERTIFICATION: This water well was plugged under my jurisdiction and was completed on (mo/day/yr) 3/27/14 and this record is true to the best of my knowledge and belief. Kansas Water Well Contractor's License No. 4/15/14 This Water Well Record was completed on (mo/day/yr) \_\_\_\_\_ under the business name of Bluestem Environmental Engineering, Inc. by (signature) *Neil Hart*

INSTRUCTIONS: Please fill in blanks and circle the correct answers. Send three copies to Kansas Department of Health and Environment, Bureau of Water, 1000 S W Jackson St., Ste. 420, Topeka, Kansas 66620-0001. Telephone: 785-298-3585. Send one to Water Well Owner and retain one for your records.