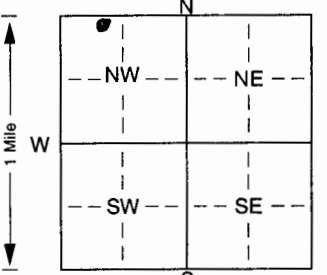


1 LOCATION OF WATER WELL: Fraction ~~1/4~~ ~~1/4~~ ~~1/4~~ Section Number 25 Township Number T 32 S Range Number R 29 E
 County: Meade
 Distance and direction from nearest town or city street address of well if located within city?
3 S + 4 1/2 W from Meade

2 WATER WELL OWNER: David Clawson
 RR#, St. Address, Box # :
 City, State, ZIP Code : Plains KS 67869
 Board of Agriculture, Division of Water Resources
 Application Number:

3 LOCATE WELL'S LOCATION WITH AN "X" IN SECTION BOX:

 4 DEPTH OF COMPLETED WELL: 296 ft. ELEVATION:
 Depth(s) Groundwater Encountered 1 ft. 2. ft. 3. ft.
 WELL'S STATIC WATER LEVEL 271.46 ft. below land surface measured on mo/day/yr 4-30-01
 Pump test data: Well water was 146.98 ft. after 1 hours pumping 30 gpm
 Est. Yield 50 gpm: Well water was 146.98 ft. after 1 hours pumping 30 gpm
 Bore Hole Diameter. 5 in. to 256 ft., and 5 in. to 296 ft.
 WELL WATER TO BE USED AS: 5 Public water supply 8 Air conditioning 11 Injection well
 Domestic 3 Feedlot 6 Oil field water supply 9 Dewatering 12 Other (Specify below)
 2 Irrigation 4 Industrial 7 Domestic (lawn & garden) 10 Monitoring well
 Was a chemical/bacteriological sample submitted to Department? Yes. ✓ No. ✓; If yes, mo/day/yr sample was submitted
 Water Well Disinfected? Yes ✓ No ✓

5 TYPE OF BLANK CASING USED:
 1 Steel 3 RMP (SR) 5 Wrought iron 8 Concrete tile CASING JOINTS: Glued. ✓ Clamped. ✓
 PVC 4 ABS 7 Fiberglass 9 Other (specify below) Welded ✓
 Blank casing diameter 5 in. to 256 ft., Dia. 5 in. to 296 ft., Dia. 5 in. to 296 ft.
 Casing height above land surface. 24 in., weight 200 lbs./ft. Wall thickness or gauge No. 200
 TYPE OF SCREEN OR PERFORATION MATERIAL:
 1 Steel 3 Stainless steel 5 Fiberglass PVC 10 Asbestos-cement
 2 Brass 4 Galvanized steel 6 Concrete tile 8 RMP (SR) 11 Other (specify) ✓
 9 ABS 12 None used (open hole)
 SCREEN OR PERFORATION OPENINGS ARE:
 1 Continuous slot 3 Mill slot 5 Gauzed wrapped Saw cut 11 None (open hole)
 2 Louvered shutter 4 Key punched 6 Wire wrapped 9 Drilled holes
 7 Torch cut 10 Other (specify) ✓ ft.
 SCREEN-PERFORATED INTERVALS: From 256 ft. to 296 ft., From 256 ft. to 296 ft.
 GRAVEL PACK INTERVALS: From 20 ft. to 296 ft., From 20 ft. to 296 ft.

6 GROUT MATERIAL: 1 Neat cement 2 Cement grout Bentonite 4 Other ✓
 Grout Intervals: From top ft. to 20 ft., From 20 ft. to 296 ft., From 20 ft. to 296 ft.
 What is the nearest source of possible contamination:
 1 Septic tank 4 Lateral lines 7 Pit privy 10 Livestock pens 14 Abandoned water well
 2 Sewer lines 5 Cess pool 8 Sewage lagoon 11 Fuel storage 15 Oil well/Gas well
 3 Watertight sewer lines 6 Seepage pit 9 Feedyard 12 Fertilizer storage 16 Other (specify below)
 13 Insecticide storage
 Direction from well? SE How many feet? 1500

FROM	TO	LITHOLOGIC LOG	FROM	TO	PLUGGING INTERVALS
0	15	cleachy top soil			
15	30	sand			
30	85	brown clay			
85	90	sand + gravel			
90	140	brown clay			
140	190	sand + gravel			
190	210	brown clay			
210	250	sand + gravel			
250	296	sand + gravel w/ streaks of clay			

7 CONTRACTOR'S OR LANDOWNER'S CERTIFICATION: This water well was (1) constructed, (2) reconstructed, or (3) plugged under my jurisdiction and was completed on (mo/day/year) 4-31-01 and this record is true to the best of my knowledge and belief. Kansas Water Well Contractor's Licence No. 101 This Water Well Record was completed on (mo/day/yr) 5-30-01 under the business name of Bartel Well Drilling, Inc. by (signature) Ruben J. Bartel