

**CORRECTION(S) TO WATER WELL RECORD (WWC-5)**  
(to rectify lacking or incorrect information)

Location listed as:

Section-Township-Range: 5-225-29

Fraction ( ¼ ¼ ¼): NE NE

County: Meade

Location changed to:

5-325-29W

SE NE NE

Other changes: Initial statements: \_\_\_\_\_

Changed to: \_\_\_\_\_

Comments: \_\_\_\_\_

verification method: Written & legal descriptions, position on plat map, water rights information in WIMAS database, and mapping tool & aerial photos on KGS website. initials: DKA date: 7/13/2012

submitted by: Kansas Geological Survey, Data Resources Library, 1930 Constant Ave., Lawrence, KS 66047-3726  
to: Kansas Dept of Health & Environment, Bureau of Water, 1000 SW Jackson, Suite 420, Topeka, KS 66612-1367.

**WATER WELL RECORD**

**Form WWC-5**

Division of Water Resources App. No.


9897

<b>1 LOCATION OF WATER WELL:</b> County: <u>Meade</u>	Fraction <u>1/4 NE 1/4 NE 1/4 1/4</u>	Section Number <u>5</u>	Township No. T <u>22</u> S	Range Number R <u>29</u> <input type="checkbox"/> E <input type="checkbox"/> W
--	--	----------------------------	-------------------------------	---

Street/Rural Address of Well Location; if unknown, distance & direction from nearest town or intersection: If at owner's address, check here .  
4 1/2 East & 3/4" North of Plains

**Global Positioning System (GPS) information:**  
Latitude: ..... (in decimal degrees)  
Longitude: ..... (in decimal degrees)  
Elevation: .....  
Datum:  WGS 84,  NAD 83,  NAD 27  
Collection Method:  
 GPS unit (Make/Model: .....)  
 Digital Map/Photo,  Topographic Map,  Land Survey  
Est. Accuracy:  <3 m,  3-5 m,  5-15 m,  >15 m

**2 WATER WELL OWNER:**  
RR#, Street Address, Box #: Gary Mead  
18596 SW Fox Road  
City, State, ZIP Code : Rose Hill, Kansas 67133

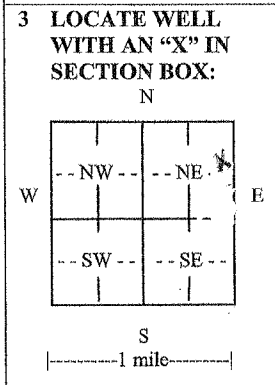

**4 DEPTH OF COMPLETED WELL** ..... 405 ft.

Depth(s) Groundwater Encountered (1).....226 ft. (2).....245 ft. (3).....346 ft.

WELL'S STATIC WATER LEVEL.....212 ft. below land surface measured on mo/day/yr.....

Pump test data: Well water was.....ft. after..... hours pumping..... gpm  
EST. YIELD. 1500 gpm. Well water was.....ft. after..... hours pumping..... gpm

Bore Hole Diameter .....27 in. to .....405 ft., and .....in. to .....ft.

WELL WATER TO BE USED AS:  Public water supply  Geothermal  Injection well  
 Domestic  Feedlot  Oil field water supply  Dewatering  Other (Specify below)  
 Irrigation  Industrial  Domestic-lawn & garden  Monitoring well

Was a chemical/bacteriological sample submitted to Department?  Yes  No

If yes, mo/day/yr sample was submitted.....  
Water well disinfected?  Yes  No

**5 TYPE OF CASING USED:**  Steel  PVC  Other .....

CASING JOINTS:  Glued  Clamped  Welded  Threaded

Casing diameter .....1.6 in. to .....285 ft., Diameter ..... in. to ..... ft.  
Casing height above land surface.....1.2 in., Weight .....lbs./ft., Wall thickness or gauge No. SDR26

TYPE OF SCREEN OR PERFORATION MATERIAL:  
 Steel  Stainless Steel  PVC  Other (Specify) .....  
 Brass  Galvanized Steel  None used (open hole)

SCREEN OR PERFORATION OPENINGS ARE:  
 Continuous slot  Mill slot  Gauze wrapped  Torch cut  Drilled holes  None (open hole)  
 Louvered shutter  Key punched  Wire wrapped  Saw cut  Other (specify) .....

SCREEN-PERFORATED INTERVALS: From.....285 ft. to .....405 ft., From ..... ft. to ..... ft.  
From..... ft. to ..... ft., From ..... ft. to ..... ft.

GRAVEL PACK INTERVALS: From.....20 ft. to .....405 ft., From ..... ft. to ..... ft.  
From..... ft. to ..... ft., From ..... ft. to ..... ft.

**6 GROUT MATERIAL:**  Neat cement  Cement grout  Bentonite  Other .....

Grout Intervals: From ...0 ft. to ...18 C. ft., From ...18 ft. to ...20 B. ft., From ..... ft. to ..... ft.

What is the nearest source of possible contamination:  
 Septic tank  Lateral lines  Pit privy  Livestock pens  Insecticide storage  Other (specify below)  
 Sewer lines  Cesspool  Sewage lagoon  Fuel storage  Abandoned water well  
 Watertight sewer lines  Seepage pit  Feedyard  Fertilizer storage  Oil well/gas well .....

Direction from well ..... Distance from well .....

FROM	TO	LITHOLOGIC LOG	FROM	TO	LITHO. LOG (cont.) or PLUGGING INTERVALS
0	20	Topsoil & clay	148	150	Cemented sand
20	40	Clay & lime	150	160	Clay & little lime
40	48	Clay	160	170	Clay & sand streaks
48	58	Clay, lime & sand	170	197	Sand, Med.
58	60	Lime	197	202	Clay
60	70	Sand & Gravel	202	220	Sand
70	80	Clay	220	225	Clay
80	100	Clay & lime	225	226	Lime
100	123	Clay	226	237	Sand
123	148	Sand	237	245	Clay

**7 CONTRACTOR'S OR LANDOWNER'S CERTIFICATION:** This water well was  constructed,  reconstructed, or  plugged under my jurisdiction and was completed on (mo/day/year) 5-27-2012 and this record is true to the best of my knowledge and belief. Kansas Water Well Contractor's License No. 223 This Water Well Record was completed on (mo/day/year) 6-15-12 under the business name of Dunham Drilling Inc. by (signature) B. Allen Dunham

**INSTRUCTIONS:** Use typewriter or ball point pen. PLEASE PRESS FIRMLY and PRINT clearly. Please fill in blanks and check the correct answers. Send three copies (white, blue, pink) to Kansas Department of Health and Environment, Bureau of Water, Geology Section, 1000 SW Jackson St., Suite 420, Topeka, Kansas 66612-1367. Telephone 785-296-5524. Send one copy to WATER WELL OWNER and retain one for your records. Include fee of \$5.00 for each constructed well. Visit us at <http://www.kdheks.gov/waterwell/index.html>.

245	261	Sand
261	300	Sand & Gravel
300	320	Sand
320	340	Sand & clay
340	346	Clay
346	360	Sand & little cemented sand
360	380	Sand & little clay
380	386	Sand & Gravel
386	405	Clay