

WATER WELL RECORD


Form WWC-5

Division of Water Resources App. No.

1 LOCATION OF WATER WELL: County: Sumner, Fraction: 1/4 NW 1/4 NE 1/4 NE 1/4, Section Number: 34, Township No. T 32 S, Range Number R 3 E W. Street/Rural Address of Well Location: Approximately 3 miles south and 13 miles west of Wellington.

Global Positioning System (GPS) information: Latitude: 37.227189, Longitude: -97.624588, Elevation: Unknown, Datum: NAD 83, Collection Method: WAAS, GPS unit (Make/Model):

2 WATER WELL OWNER: City of Wellington, RR#, Street Address, Box #: 317 S. Washington, City, State, ZIP Code: Wellington, KS 67202

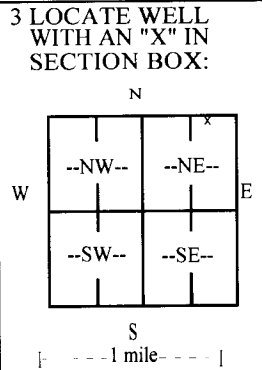

3 LOCATE WELL WITH AN 'X' IN SECTION BOX: 4 DEPTH OF COMPLETED WELL 51 ft. Depth(s) Groundwater Encountered (1) 22.55 ft. (2) ft. (3) ft. WELL'S STATIC WATER LEVEL 22.55 ft. below land surface measured on mo/day/yr 01/14/15. Pump test data: Well water was not checked ft. after hours pumping gpm. EST. YIELD gpm. Well water was ft. after hours pumping gpm. Bore Hole Diameter 9 in. to 53 ft., and in. to ft. WELL WATER TO BE USED AS: Public water supply, Geothermal, Injection well, Domestic, Feedlot, Oil field water supply, Dewatering, Other (Specify below) Test Well, Irrigation, Industrial, Domestic-lawn & garden, Monitoring well. Was a chemical/bacteriological sample submitted to Department? Yes No. If yes, mo/day/yr sample was submitted. Water well disinfected? Yes No.

5 TYPE OF CASING USED: Steel PVC Other. CASING JOINTS: Glued Clamped Welded Threaded Other (Specify). Casing diameter 5 in. to 29 ft., Diameter in. to ft., Diameter in. to ft. Casing height above land surface 24 in., Weight 2.36 lbs./ft., Wall thickness or gauge No. .214. TYPE OF SCREEN OR PERFORATION MATERIAL: Steel Stainless Steel PVC Other (Specify), Brass Galvanized Steel None used (open hole). SCREEN OR PERFORATION OPENINGS ARE: Continuous slot Mill slot Gauze wrapped Torch cut Drilled holes None (open hole), Louvered shutter Key punched Wire wrapped Saw cut Other (specify). SCREEN-PERFORATED INTERVALS: From 29 ft. to 49 ft., From ft. to ft., From ft. to ft., From ft. to ft. GRAVEL PACK INTERVALS: From 28 ft. to 49 ft., From ft. to ft., From ft. to ft., From ft. to ft.

6 GROUT MATERIAL: Neat cement Cement grout Bentonite Other. Grout Intervals: From 2 ft. to 28 ft., From ft. to ft., From ft. to ft., From ft. to ft. What is the nearest source of possible contamination: Septic tank Lateral lines Pit privy Livestock pens Insecticide storage Other (specify below), Sewer lines Cesspool Sewage lagoon Fuel storage Abandoned water well, Watertight sewer lines Seepage pit Feedyard Fertilizer storage Oil well/gas well. Direction from well North Distance from well 10. TH-11-15

Table with columns: FROM, TO, LITHOLOGIC LOG, FROM, TO, LITHO. LOG (cont.) or PLUGGING INTERVALS. Rows include: 0-2 Topsoil, 2-9 Clay, brown, 9-15 Clay, brown, caliche, 15-29 Clay, brown, 29-50 Sand, gravel, fine to medium, shale pieces, 50-53 Shale, green, red.

7 CONTRACTOR'S OR LANDOWNER'S CERTIFICATION: This water well was constructed, reconstructed, or plugged under my jurisdiction and was completed on (mo/day/year) 01/14/15 and this record is true to the best of my knowledge and belief. Kansas Water Well Contractor's License No. 185 This Water Well Record was completed on (mo/day/year) 01/28/15 under the business name of Clarke Well & Equipment, Inc. by (signature) [Signature]

INSTRUCTIONS: Use typewriter or ball point pen. PLEASE PRESS FIRMLY and PRINT clearly. Please fill in blanks and check the correct answers. Send three copies (white, blue, pink) to Kansas Department of Health and Environment, Bureau of Water, Geology Section, 1000 SW Jackson St., Suite 420, Topeka, Kansas 66612-1367. Telephone 785-296-5522. Send one copy to WATER WELL OWNER and retain one for your records. Include fee of \$5.00 for each constructed well. Visit us at http://www.kdheks.gov/waterwell/index.html.