

WATER WELL RECORD

Form WWC-5

Division of Water Resources App. No.


Well ID

MW15

Original Record Correction Change in Well Ust

1 LOCATION OF WATER WELL: County Sumner Fraction SE 1/4 SE 1/4 SE 1/4 SE 1/4 Section Number 18 Township Number T 32 S Range Number R 3 E X W

2 WELL OWNER: Last Name: Business: KDHE Address: 1000 SW Jackson Blvd. City Topeka State KS ZIP: 66612 Street or Rural Address where well is located (if unknown, distance and direction from nearest town or intersection): ~60' NW of 110 N. Monroe St. Milan, KS 67105

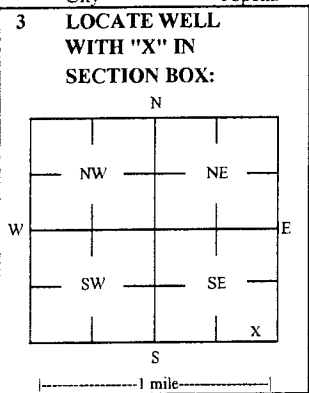

4 DEPTH OF COMPLETED WELL: 35.21 ft Depth(s) Groundwater Encountered: 1) 35.21 ft 2) ft 3) ft or 4) Dry Well WELL'S STATIC WATER LEVEL: 23.35 ft

5 Latitude: 37.25718 (decimal degrees) Longitude: 97.67422 (decimal degrees) Horizontal Datum: X WGS 84 GPS (unit make/model):

6 Elevation: 1222.85 ft Ground Level: X TOC Source: X Land Survey GPS Topographic Map

7 WELL WATER TO BE USED AS: 1 Domestic: Household, Lawn & Garden, Livestock, Irrigation, Feedlot, Industrial 2 Public Water Supply: well ID 3 Dewatering: how many wells? 4 Aquifer Recharge: well ID 5 Monitoring: well ID MW15 6 Environmental Remediation: well ID 7 Air Sparge 8 Soil Vapor Extractor 9 Recovery 10 Injection 11 Oil Field Water Supply: lease 12 Test Hole: well ID 13 Cased 14 Uncased 15 Geotechnical 16 Geothermal: How many bores? 17 a) Closed Loop 18 Horizontal 19 Vertical 20 b) Open Loop 21 Surface Discharge 22 Inj. of Water 23 Other (specify):

Was a chemical/bacteriological sample submitted to KDHE? Yes No X No If yes, date sample was submitted: Water well disinfected? Yes No X No

8 TYPE OF CASING USED: Steel X PVC Other CASING JOINTS: Glued Clamped Welded X Threaded Casing diameter 2 in. to 20.21 ft, Diameter in. to ft, Diameter in. to ft, Casing height above land surface -0.46 in. Weight lbs./ft. Well thickness or gauge No TYPE OF SCREEN OR PERFORATION MATERIAL: Steel Stainless Steel Fiberglass X PVC Other (Specify) Brass Galvanized Steel Concrete tile None used (open hole) SCREEN OR PERFORATION OPENINGS ARE: Continuous Slot X Mill Slot Gauze Wrapped Torch Cut Drilled Holes Other (Specify) Louvered Shutter Key Punched Wire Wrapped Saw Cut None (Open Hole) SCREEN-PERFORATED INTERVALS: From 20.21 ft. to 35.21 ft. GRAVEL PACK INTERVALS: From 18 ft. to 35.5 ft.

9 GROUT MATERIAL: Neat cement Cement grout X Bentonite X Other Concrete: 0-1' Grout intervals: From 1 ft. to 18 ft. From ft. to ft. From ft. to ft.

Nearest source of possible contamination: Septic Tank Lateral Lines Pit Privy Livestock Pens Insecticide Storage Sewer Lines Cess Pool Sewage Lagoon X Fuel Storage Abandoned Water Well Watertight Sewer Lines Seepage Pit Feedyard Fertilizer Storage Oil Well / Gas Well Other (Specify) Direction from well? SE Distance from well? ~60' ft

10 FROM TO LITHOLOGIC LOG FROM TO LITHO. LOG (cont.) or PLUGGING INTERVALS

0	0.7	Topsoil			
0.7	4	Brown silty clay, some Fe staining			
4	8	Brown to tan medium sandy clay			
8	11	Red-brown sandy clay			
11	14	Reddish brown medium silty sand			
14	20	Reddish brown clayey silt			
20	24	Reddish brown silty clay			
24	24.3	Reddish brown sandy clay			
24.3	35.5	Reddish brown silty clay			

Notes: KDHE ID: Former Station - Milan; U2-096-14645

11 CONTRACTOR'S OR LANDOWNER'S CERTIFICATION: This water well was X constructed, reconstructed, or plugged under my jurisdiction and was completed on (mo-day-year) 11/4/15 and this record is true to the best of my knowledge and belief. Kansas Water Well Contractor's License No 757 This Water Well Record was completed on (mo-day-year) 12/7/15 under the business name of Larsen & Associates, Inc. Signature

TRITERRA LAND SERVICES

P.O. Box 546
Clearwater, Kansas 67026
Cell (316) 648-3617 Fax (620) 584-4371
E-mail: triterrals@yahoo.com

SURVEYING OF ADDITIONAL MONITORING WELLS FORMER STATION MILAN, KANSAS

The above site is located in Section 18, Township 32 South, Range 3 West of the Sixth Principal Meridian, Sumner County, Kansas. The Southeast corner of Section 18 was assigned coordinates of 00.00 North and 00.00 West.

The vertical control was an NGS benchmark (A 314 1956) described as a disk set vertically in the north brick wall of the school building, 2.1 feet west of the northeast corner and 2.8 feet above the ground. Elevation: 1224.68 feet. A control point was set as a chiseled 'X' at the southeast corner of the building on the Abandoned Tank site.

The Latitude and Longitude were recorded from a GPS unit. The site is located on the 7.5' quad map titled "Milan".

ID	NORTH	WEST	LATITUDE	LONGITUDE	ELEVATION
SE CORNER 18-32S-3W	00.00	00.00			
Control Point	70.66	59.33	37.25666	97.67429	1224.10
MW-10(Sec 17) SW SW SW SW	242.38	-141.71	37.25712	97.67359	RIM 1221.19 TOC 1220.56
MW-11(Sec 17) SW SW SW SW	233.32	-55.38	37.25711	97.67388	RIM 1223.04 TOC 1222.65
MW-12(Sec 17) SW SW SW SW	110.13	-86.72	37.25676	97.67377	RIM 1223.43 TOC 1222.81
MW-13(Sec 17) SW SW SW SW	57.04	-60.27	37.25663	97.67387	RIM 1224.19 TOC 1223.89
MW-14(Sec 18) SE SE SE SE	223.31	147.13	37.25706	97.67456	RIM 1223.48 TOC 1222.99
MW-15(Sec 18) SE SE SE SE	259.14	35.93	37.25718	97.67422	RIM 1223.31 TOC 1222.85

